







Protected by copyright. Passing on as well as reproduction of this document, its utilization and communication of its contents are prohibited in as far as not expressly permitted.

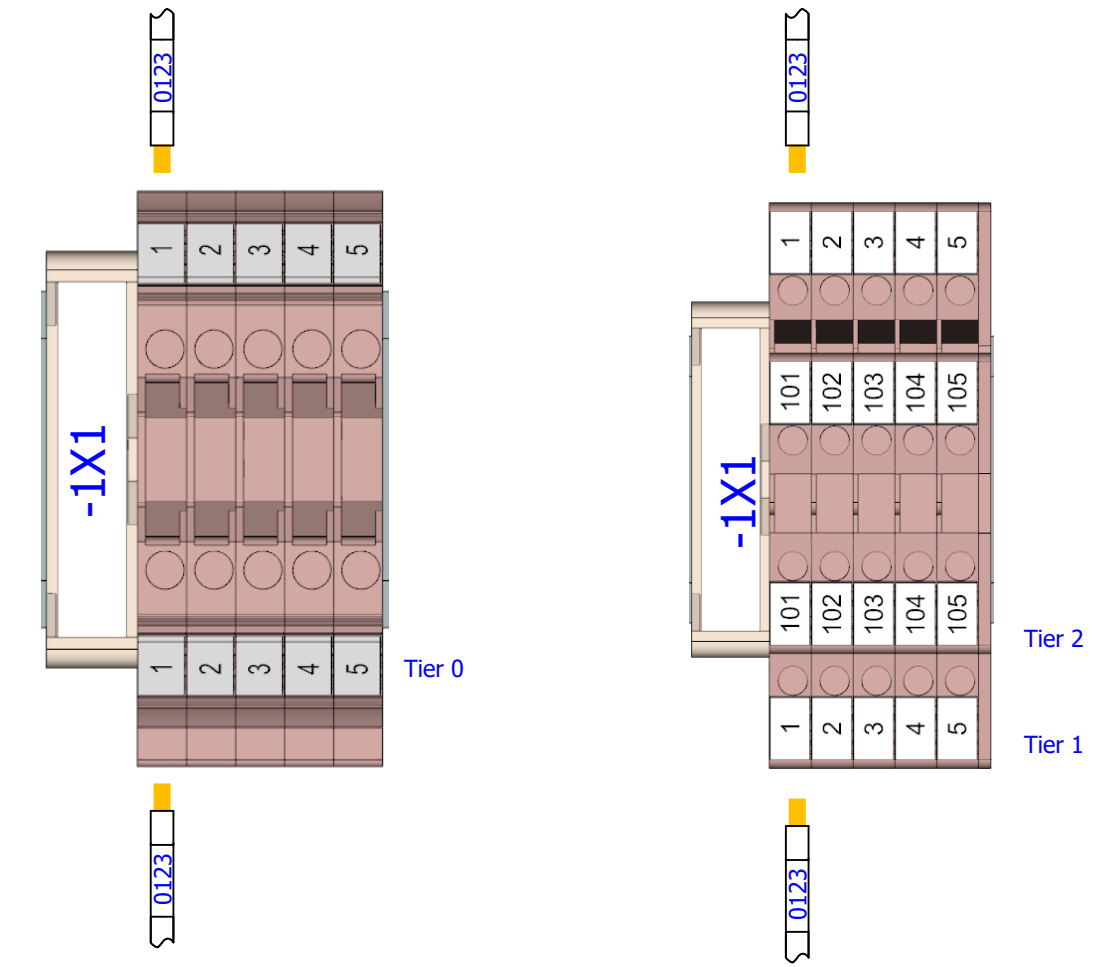

TERMINAL TIER (WEIDMULLER, CHECK FOR OTHER MANUFACTURERS)  
0 = SINGLE TIER TERMINAL  
1 = LOWER TIER ON MULTI TIER  
2 = UPPER TIER ON MULTI TIER

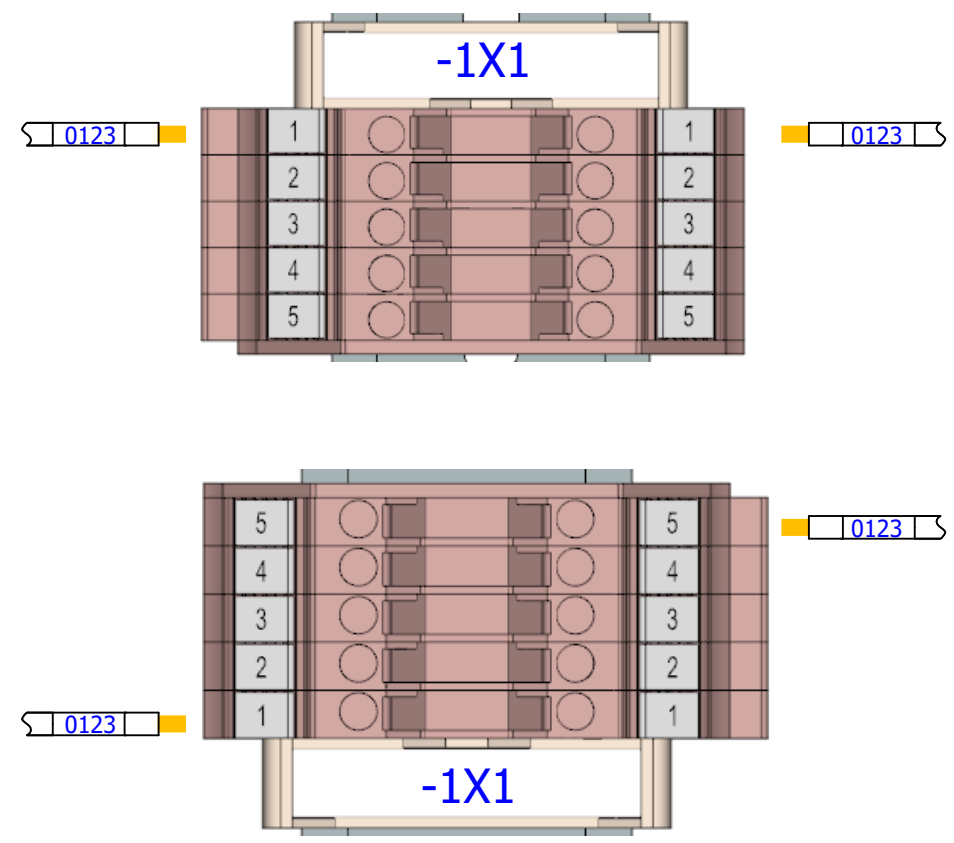

Protected by copyright. Passing on as well as reproduction of this document, its utilization and communication of its contents are prohibited in as far as not expressly permitted.

## NOTES

|     |                   |
|-----|-------------------|
| 0.# | INTERNAL REVISION |
| A   | CLIENT ISSUE      |

Protected by copyright. Passing on as well as reproduction of this document, its utilization and communication of its contents are prohibited in as far as not expressly permitted.






| Manufacturer        | Manufacturer Part No | Description                                                                                       | Quantity |
|---------------------|----------------------|---------------------------------------------------------------------------------------------------|----------|
| Alpha Wire          | 6412 SL005           | Multipair Cable, Communication, Screened, 1 Pair, 24 AWG, 0.23 mm², 100 ft, 30.5 m                | 11       |
| Alpha Wire          | 5472C SL005          | Twisted Pair Data Cable, 2 Pairs, 0.23 mm², 4 Cores, 24 AWG, Screened, 30m, Grey Sheath           | 4        |
| Beckhoff Automation | EL9011               | Bus end cover for ELxxxx, cover for power and E-bus contacts, gray                                | 1        |
| Beckhoff Automation | EL9550               | Surge filter system and field supply                                                              | 1        |
| Beckhoff Automation | EK1100               | EtherCAT Coupler for E-bus terminals (ELxxxx)                                                     | 1        |
| Beckhoff Automation | ELM3148-0000         | EtherCAT Terminal, 8-channel analog input, multi-function, ±10...±1.25 V, ±20 mA, 24 bit, 1 ksp/s | 2        |
| Beckhoff Automation | EL3314               | EtherCAT Terminal, 4-channel analog input, temperature, thermocouple, 16 bit                      | 1        |
| Beckhoff Automation | EL1409               | EtherCAT Terminal, 16-channel digital input, 24 V DC, 3 ms                                        | 1        |
| Beckhoff Automation | EL2869               | EtherCAT Terminal, 16-channel digital output, 24 V DC, 0.5 A, with channel diagnostics            | 1        |
| Clynder Cable       | 1.0-DKBLU-TRI        | DARK BLUE, 1.0mm, Tri-Rated Cable Single Core                                                     | 1        |
| IBOCO Corporation   | T1-40X80G            | Grey PVC 40 x 80                                                                                  | 3        |
| IBOCO Corporation   | T1-25X80G            | Grey PVC 25 x 80                                                                                  | 1        |
| LCA Group           | CS00006              | Enclosure Danger Warning Label                                                                    | 1        |
| LCA Group           | CS00007              | 140x30 - Enclosure Main Label                                                                     | 1        |
| LCA Group           | CS00205              | UKCA Rating label                                                                                 | 1        |
| LCA Group           | CS00185              | Label 30x15 mm                                                                                    | 6        |
| Neutrik             | NJ3FP6C              | Locking 1/4" phone jack, D-size shell, nickel metal housing and silver contacts                   | 1        |
| Neutrik             | NC3FD-L-1            | 3 pole female receptacle, solder cups, Nickel housing, silver contacts                            | 12       |
| Neutrik             | NAC3MPXXA            | Appliance inlet connector, 3/16" flat tab terminals, blue                                         | 1        |
| Neutrik             | NAHDMI-W             | HDMI feedthrough adapter, D-shape housing                                                         | 1        |
| Neutrik             | NC4FD-L-1            | 4 pole female receptacle, solder cups, Nickel housing, silver contacts                            | 4        |
| OKDO                | RP001B               | Okdo 1m HDMI to Micro HDMI Cable in Black                                                         | 1        |
| Phoenix Contact     | PTFIX-NS35           | Mounting rail adapter                                                                             | 1        |
| Phoenix Contact     | PTFIX 12X2,5 GY      | Potential distribution block                                                                      | 1        |
| Phoenix Contact     | PTFIX 6X2,5 BU       | Potential distribution block                                                                      | 1        |




| Manufacturer | Manufacturer Part No | Description                | Quantity |
|--------------|----------------------|----------------------------|----------|
| Weidmueller  | SH 1                 | Busbar support             | 2        |
| Weidmueller  | SSCH 10X3X1000 CU/SN | Busbar (terminal)          | 1        |
| Weidmueller  | WDU 2.5              | WDU 2.5                    | 2        |
| Weidmueller  | ZQV 2.5N/2           | Cross-connector (terminal) | 1        |
| Weidmueller  | WPE 2.5              | PE terminal                | 2        |
| Weidmueller  | WAP 2.5-10           | End plate (terminals)      | 1        |



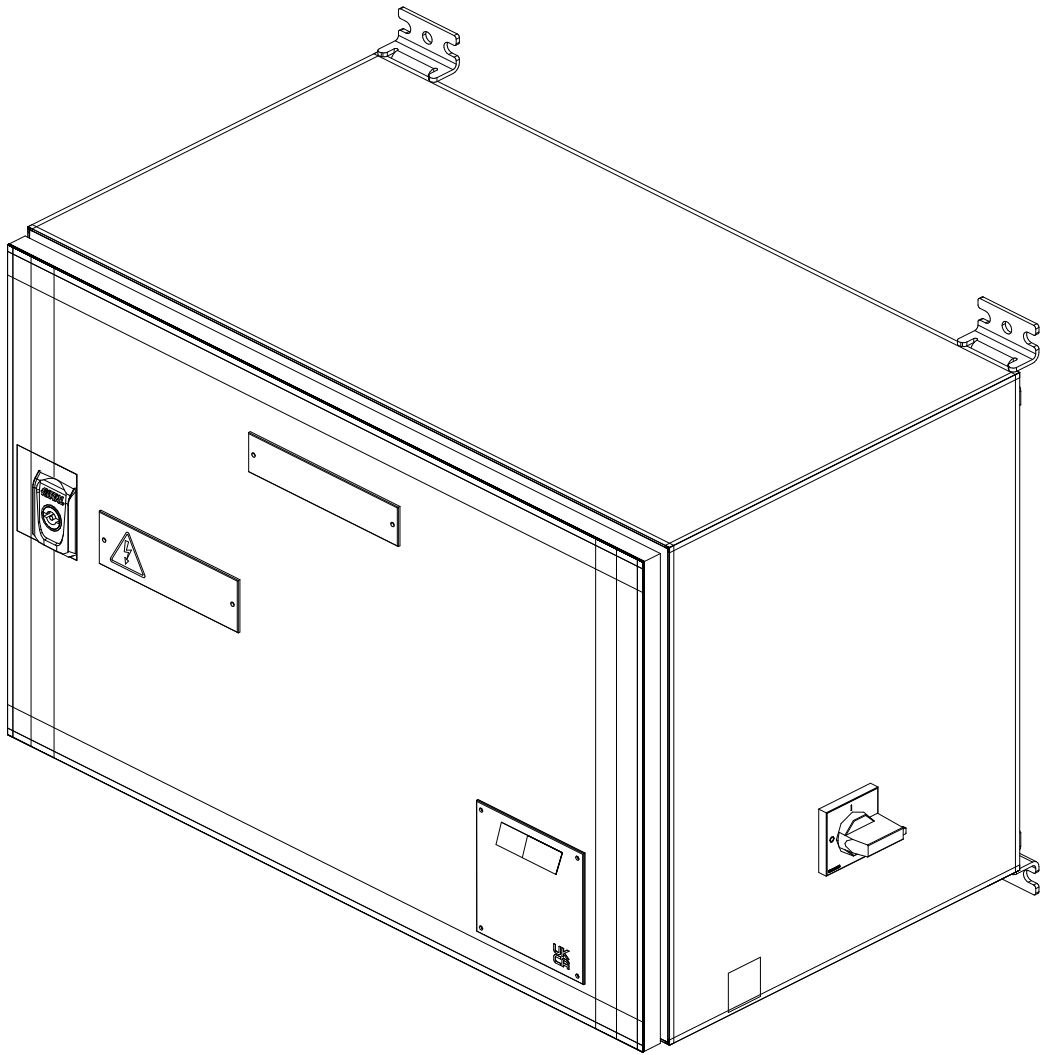


ENCLOSURE SE

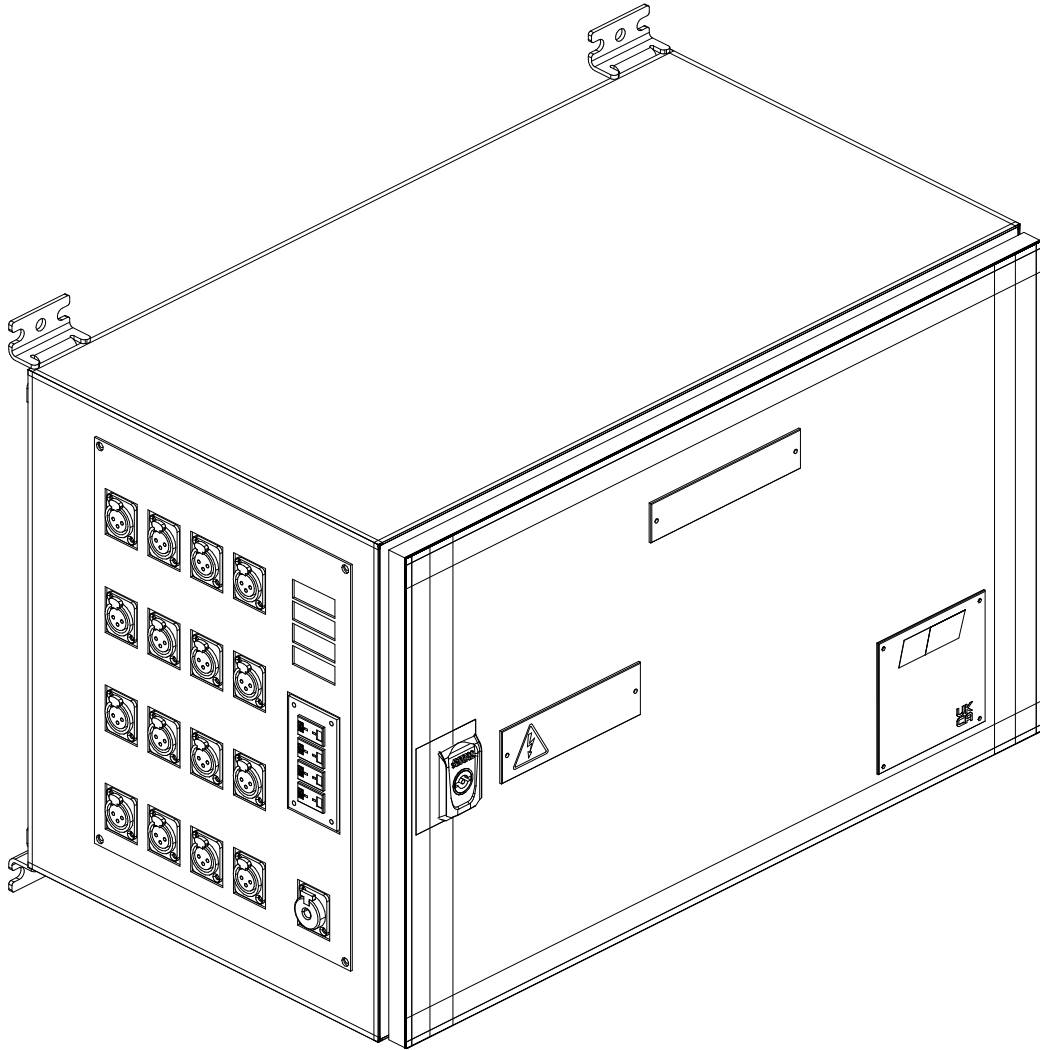


ENCLOSURE NW

|     |      |          |                 |            |             |                 |                       |      |                      |                                                                                         |                                                     |       |                    |           |
|-----|------|----------|-----------------|------------|-------------|-----------------|-----------------------|------|----------------------|-----------------------------------------------------------------------------------------|-----------------------------------------------------|-------|--------------------|-----------|
| REV | B    | 17/10/25 | AS BUILTS       | R.WATTS    | M.DUTTON    | N/A             | LCA PROJECT NUMBER    | 7168 | <div>LCA Group</div> | PROJECT DESCRIPTION<br>OLIVER VALVETEK LTD -DATA LOGGER<br>CONTROL PANEL PRODUCTION RUN | PAGE DESCRIPTION<br>MODEL VIEW - ENCLOSURE OVERVIEW | =CS1  | LCA DRAWING NUMBER | PAGE      |
|     | A    | 03/07/25 | CLIENT COMMENTS | M.DUTTON   | M.PENDLETON | N/A             | CLIENT PROJECT NUMBER |      |                      |                                                                                         |                                                     |       | 7168-DWG-100       | 100       |
|     | 2.0  | 03/07/25 | CLIENT COMMENTS | M.DUTTON   | M.PENDLETON | N/A             | CLIENT DRAWING NUMBER |      |                      |                                                                                         |                                                     | +CP1  | REVISION           | NEXT PAGE |
|     | DATE | COMMENT  | DRAWN BY        | CHECKED BY | APPROVED BY | CLIENT APPROVER |                       |      |                      |                                                                                         |                                                     | &ETC1 | B                  | 101       |
|     |      |          |                 |            |             |                 |                       |      |                      |                                                                                         |                                                     |       |                    |           |

Protected by copyright. Passing on as well as reproduction of this document, its utilization and communication of its contents are prohibited in as far as not expressly permitted.

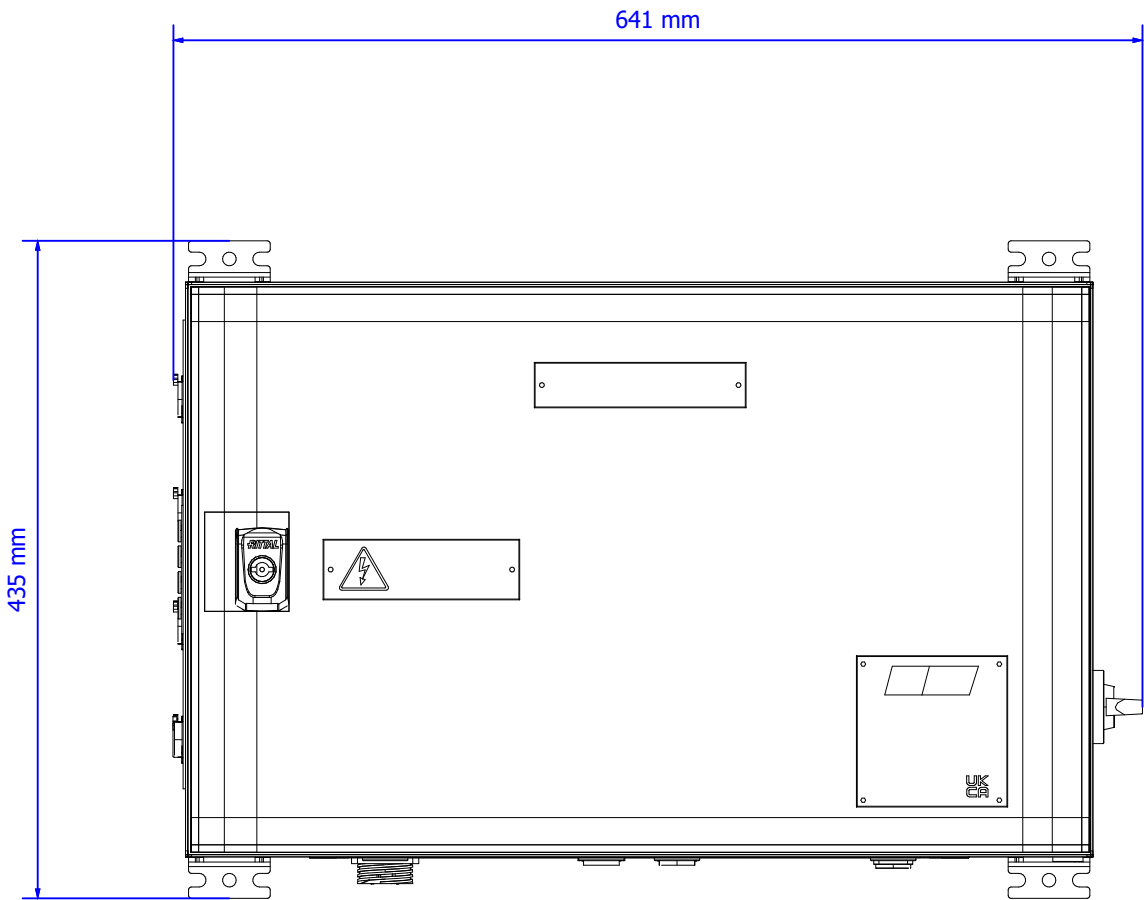

ENCLOSURE FRONT

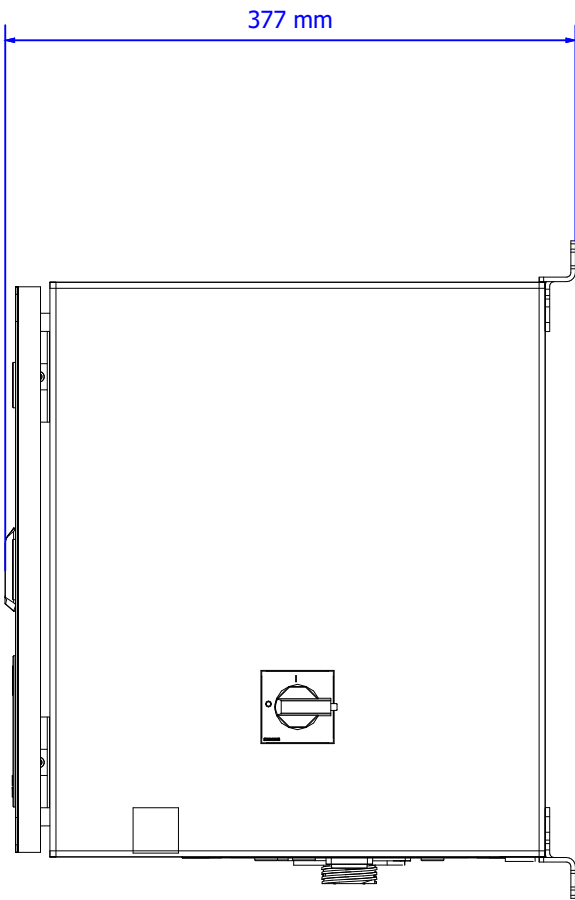


ENCLOSURE RIGHT


SECURITY CLASIFICATION : NONE

|     |      |          |                 |            |             |                 |                       |      |                      |                                                                                         |                                                       |       |                    |           |
|-----|------|----------|-----------------|------------|-------------|-----------------|-----------------------|------|----------------------|-----------------------------------------------------------------------------------------|-------------------------------------------------------|-------|--------------------|-----------|
| REV | B    | 17/10/25 | AS BUILTS       | R.WATTS    | M.DUTTON    | N/A             | LCA PROJECT NUMBER    | 7168 | <div>LCA Group</div> | PROJECT DESCRIPTION<br>OLIVER VALVETEK LTD -DATA LOGGER<br>CONTROL PANEL PRODUCTION RUN | PAGE DESCRIPTION<br>MODEL VIEW - ENCLOSURE DIMENSIONS | =CS1  | LCA DRAWING NUMBER | PAGE      |
|     | A    | 03/07/25 | CLIENT COMMENTS | M.DUTTON   | M.PENDLETON | N/A             | CLIENT PROJECT NUMBER |      |                      |                                                                                         |                                                       |       | 7168-DWG-100       | 101       |
|     | 2.0  | 03/07/25 | CLIENT COMMENTS | M.DUTTON   | M.PENDLETON | N/A             | CLIENT DRAWING NUMBER |      |                      |                                                                                         |                                                       | +CP1  | REVISION           | NEXT PAGE |
|     | DATE | COMMENT  | DRAWN BY        | CHECKED BY | APPROVED BY | CLIENT APPROVER |                       |      |                      |                                                                                         |                                                       | &ETC1 | B                  | 102       |

Protected by copyright. Passing on as well as reproduction of this document, its utilization and communication of its contents are prohibited in as far as not expressly permitted.

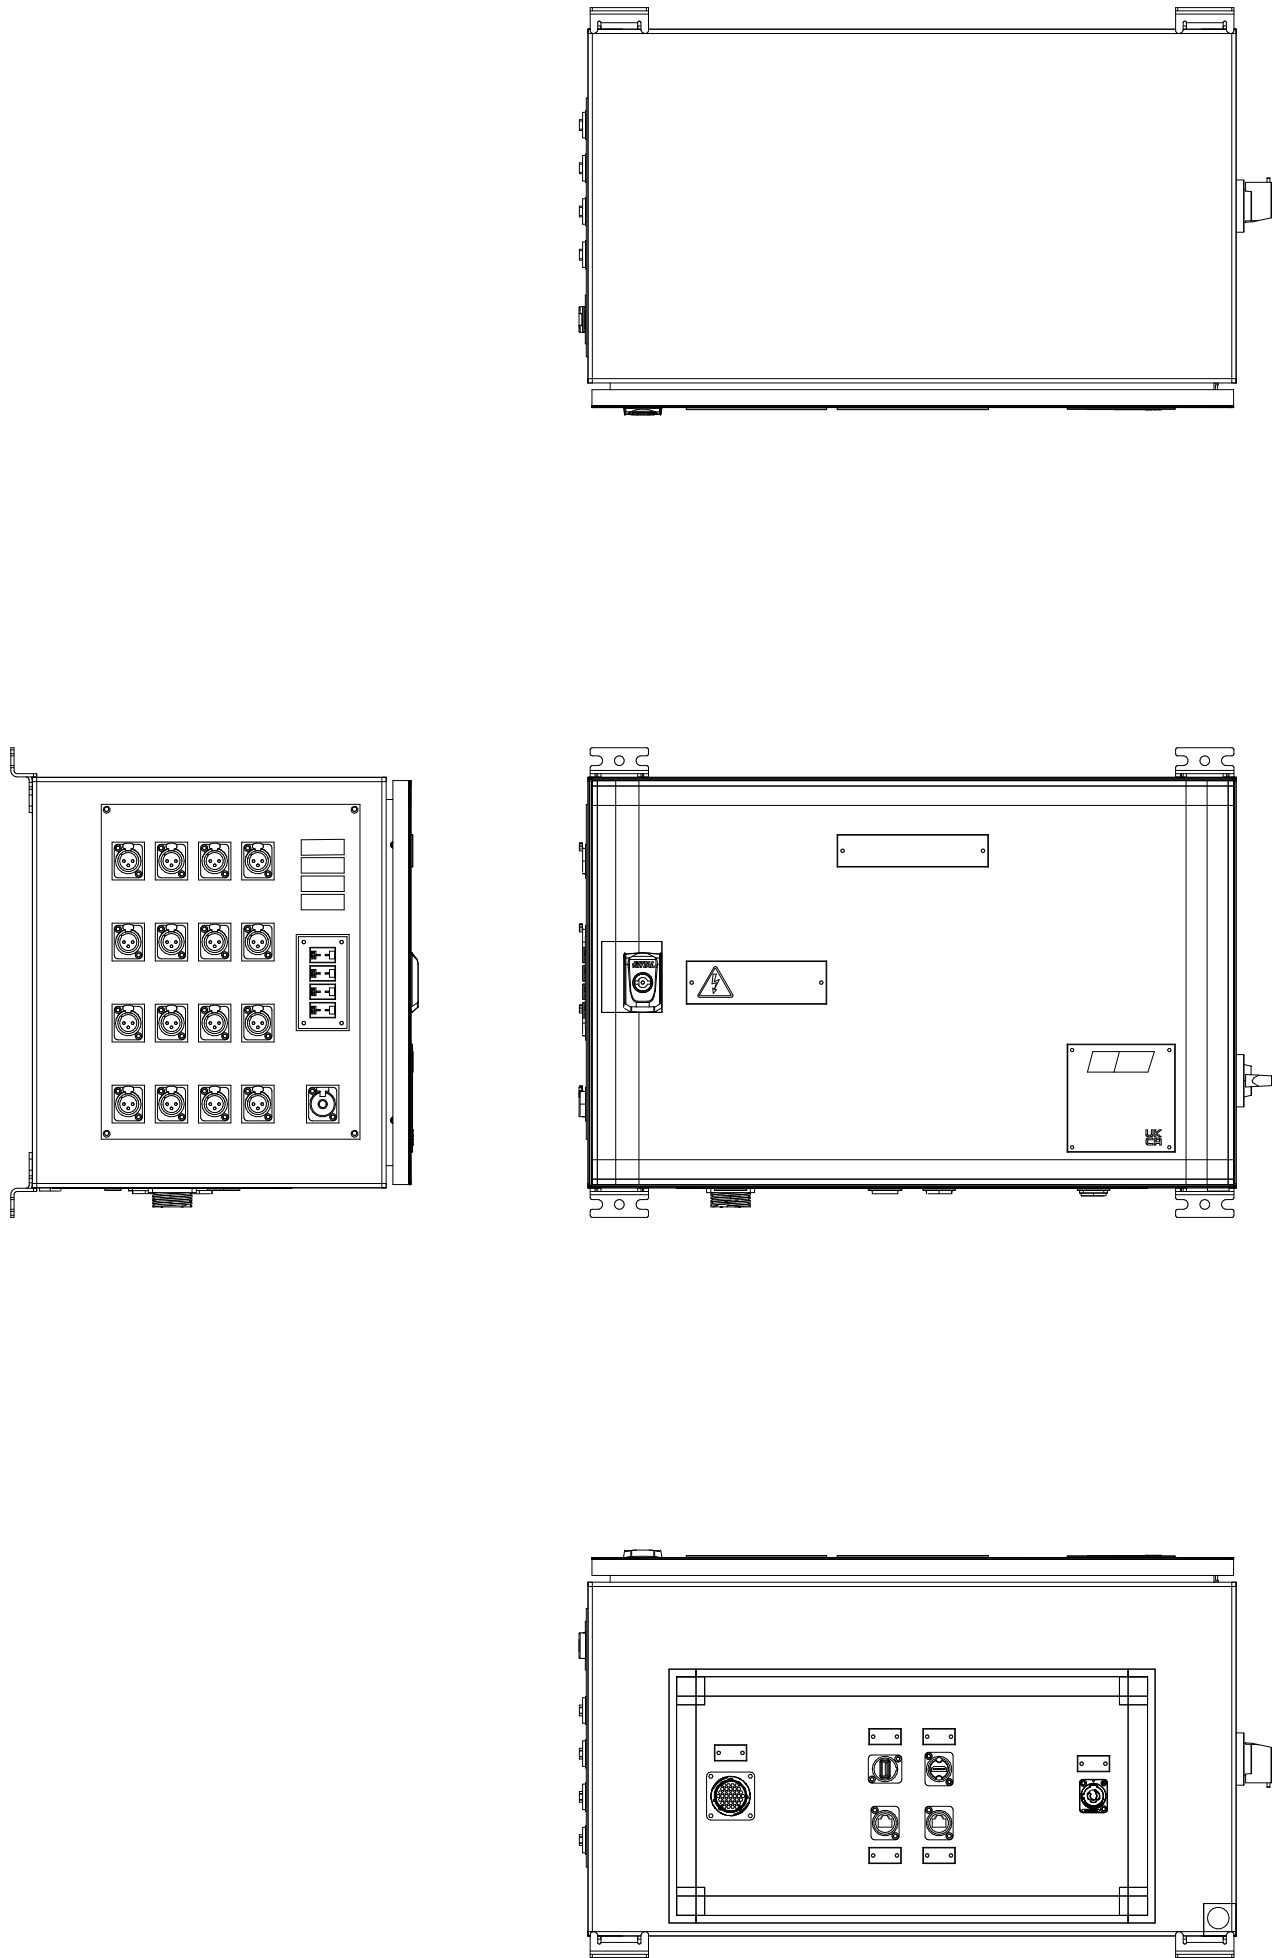


SECURITY CLASIFICATION : NONE

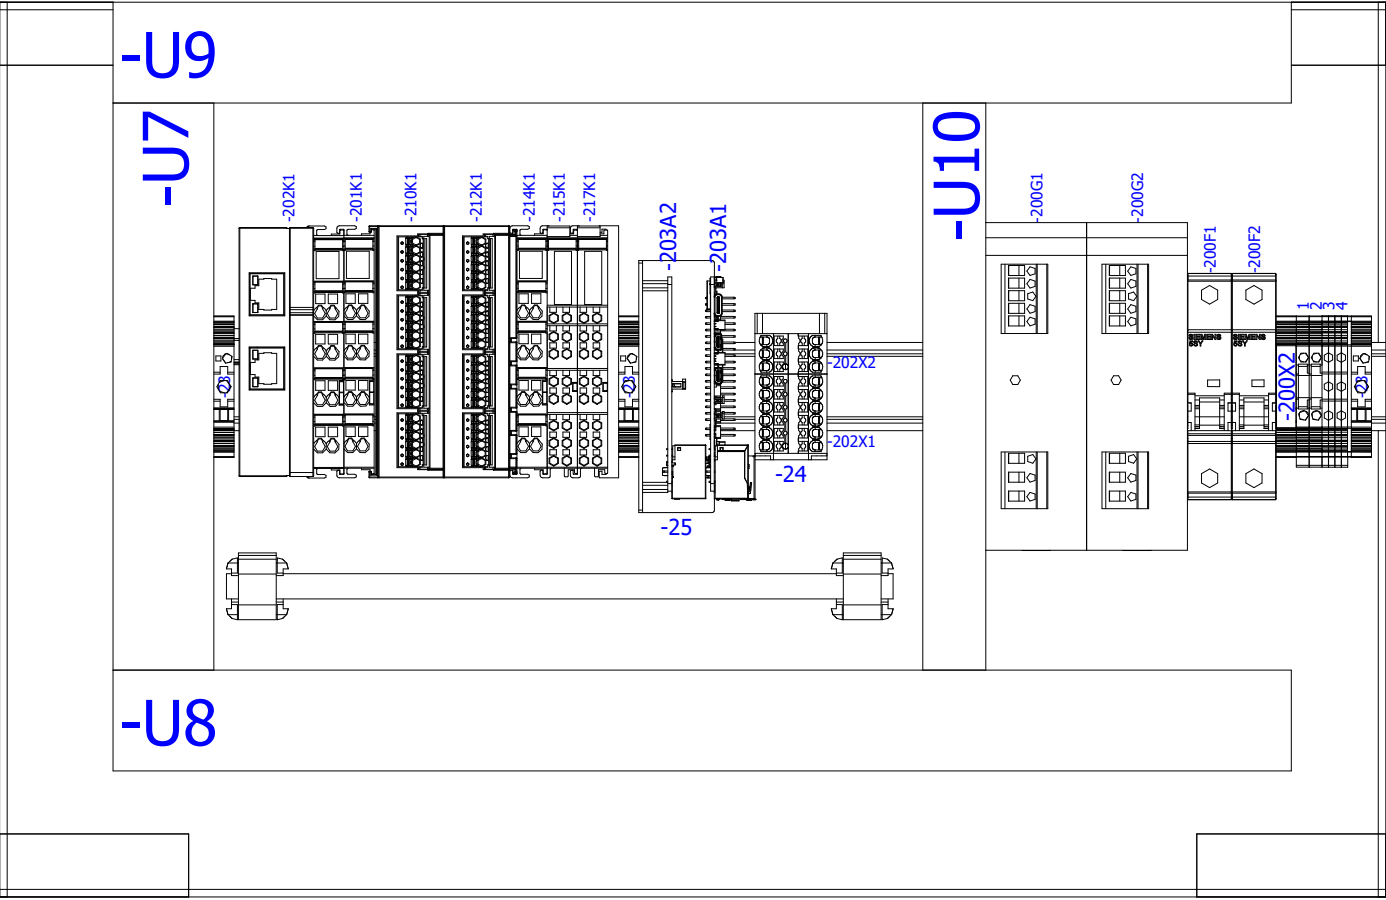

BACKPLATE w/ COMPONENTS

SECURITY CLASIFICATION : NONE

|     |      |          |                 |            |             |                 |                       |      |                      |                                                                                         |                                            |       |                    |           |
|-----|------|----------|-----------------|------------|-------------|-----------------|-----------------------|------|----------------------|-----------------------------------------------------------------------------------------|--------------------------------------------|-------|--------------------|-----------|
| REV | B    | 17/10/25 | AS BUILTS       | R.WATTS    | M.DUTTON    | N/A             | LCA PROJECT NUMBER    | 7168 | <div>LCA Group</div> | PROJECT DESCRIPTION<br>OLIVER VALVETEK LTD -DATA LOGGER<br>CONTROL PANEL PRODUCTION RUN | PAGE DESCRIPTION<br>MODEL VIEW - BACKPLATE | =CS1  | LCA DRAWING NUMBER | PAGE      |
|     | A    | 03/07/25 | CLIENT COMMENTS | M.DUTTON   | M.PENDLETON | N/A             | CLIENT PROJECT NUMBER |      |                      |                                                                                         |                                            |       | 7168-DWG-100       | 103       |
|     | 2.0  | 03/07/25 | CLIENT COMMENTS | M.DUTTON   | M.PENDLETON | N/A             | CLIENT DRAWING NUMBER |      |                      |                                                                                         |                                            | +CP1  | REVISION           | NEXT PAGE |
|     | DATE | COMMENT  | DRAWN BY        | CHECKED BY | APPROVED BY | CLIENT APPROVER |                       |      |                      |                                                                                         |                                            | &ETC1 | B                  | 104       |

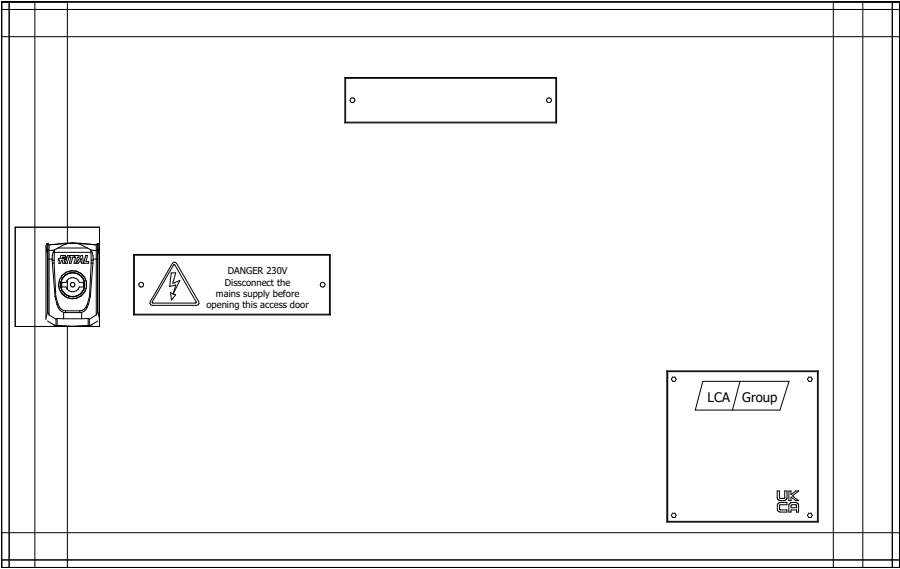


DOOR

SECURITY CLASIFICATION : NONE

|     |          |                 |          |             |             |                       |      |                                                                                       |                                                                                         |                                       |       |                    |           |
|-----|----------|-----------------|----------|-------------|-------------|-----------------------|------|---------------------------------------------------------------------------------------|-----------------------------------------------------------------------------------------|---------------------------------------|-------|--------------------|-----------|
| B   | 17/10/25 | AS BUILTS       | R.WATTS  | M.DUTTON    | N/A         | LCA PROJECT NUMBER    | 7168 |  | PROJECT DESCRIPTION<br>OLIVER VALVETEK LTD -DATA LOGGER<br>CONTROL PANEL PRODUCTION RUN | PAGE DESCRIPTION<br>MODEL VIEW - DOOR | =CS1  | LCA DRAWING NUMBER | PAGE      |
| A   | 03/07/25 | CLIENT COMMENTS | M.DUTTON | M.PENDLETON | N/A         | CLIENT PROJECT NUMBER |      |                                                                                       |                                                                                         |                                       |       | 7168-DWG-100       | 104       |
| 2.0 | 03/07/25 | CLIENT COMMENTS | M.DUTTON | M.PENDLETON | N/A         | CLIENT DRAWING NUMBER |      |                                                                                       |                                                                                         |                                       | +CP1  | REVISION           | NEXT PAGE |
| REV | DATE     | COMMENT         | DRAWN BY | CHECKED BY  | APPROVED BY | CLIENT APPROVER       |      |                                                                                       |                                                                                         |                                       | &ETC1 | B                  | 105       |
|     |          |                 |          |             |             |                       |      |                                                                                       |                                                                                         |                                       |       |                    |           |

LEFT SIDE

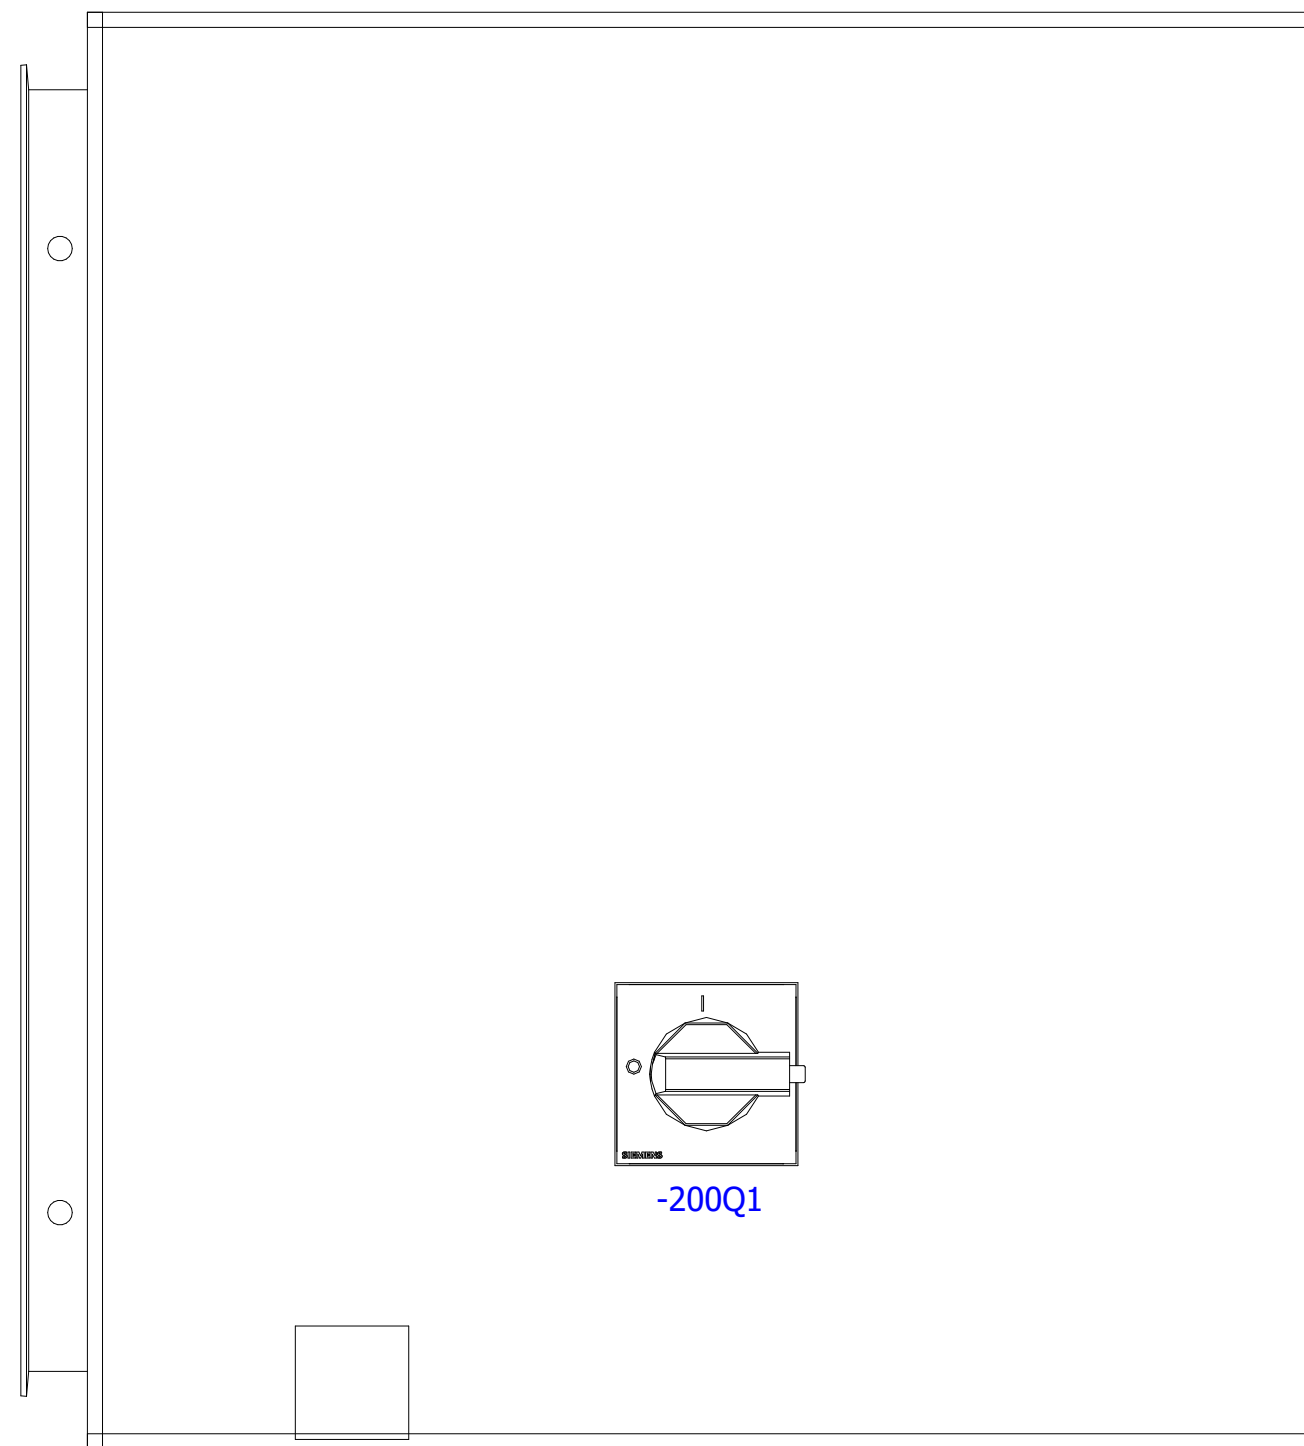

SECURITY CLASSIFICATION : NONE

[illegible]



Technical drawing of the rear panel of a 19-inch rack-mountable device. The panel features a central 24-pin D-sub connector labeled -202X3, a 15-pin D-sub connector labeled -200X1, and four BNC connectors labeled -203X2, -203X1, -203X3, and -202X4. Mounting brackets are shown on the left and right sides.

The diagram shows the rear panel of the device with the following ports and labels:

- DI/DO**: A circular port with many pins, labeled **-202X3** in blue.
- USB**: A standard USB Type-A port, labeled **-203X2** in blue.
- HDMI**: An HDMI Type-A port, labeled **-203X1** in blue.
- IN**: A circular port with a single pin, labeled **-203X3** in blue.
- OUT**: A circular port with a single pin, labeled **-202X4** in blue.
- PWR**: A circular power jack port, labeled **-200X1** in blue.


## GLAND PLATE

SECURITY CLASSIFICATION : NONE

|     |  |          |                 |          |             |             |                       |      |                                                                                       |                                                                                         |                                             |                               |                    |           |
|-----|--|----------|-----------------|----------|-------------|-------------|-----------------------|------|---------------------------------------------------------------------------------------|-----------------------------------------------------------------------------------------|---------------------------------------------|-------------------------------|--------------------|-----------|
| B   |  | 17/10/25 | AS BUILTS       | R.WATTS  | M.DUTTON    | N/A         | LCA PROJECT NUMBER    | 7168 |  | PROJECT DESCRIPTION<br>OLIVER VALVETEK LTD -DATA LOGGER<br>CONTROL PANEL PRODUCTION RUN | PAGE DESCRIPTION<br>MODEL VIEW - TOP/BOTTOM | SECURITY CLASSIFICATION: NONE |                    |           |
| A   |  | 03/07/25 | CLIENT COMMENTS | M.DUTTON | M.PENDLETON | N/A         | CLIENT PROJECT NUMBER |      |                                                                                       |                                                                                         |                                             | =CS1                          | LCA DRAWING NUMBER | PAGE      |
| 2.0 |  | 03/07/25 | CLIENT COMMENTS | M.DUTTON | M.PENDLETON | N/A         | CLIENT DRAWING NUMBER |      |                                                                                       |                                                                                         |                                             |                               | 7168-DWG-100       | 106       |
| REV |  | DATE     | COMMENT         | DRAWN BY | CHECKED BY  | APPROVED BY | CLIENT APPROVER       |      |                                                                                       |                                                                                         |                                             | +CP1                          | REVISION           | NEXT PAGE |
|     |  |          |                 |          |             |             |                       |      |                                                                                       |                                                                                         |                                             | &ETC1                         | B                  | &EPB1/140 |











Protected by copyright. Passing on as well as reproduction of this document, its utilization and communication of its contents are prohibited in as far as not expressly permitted.

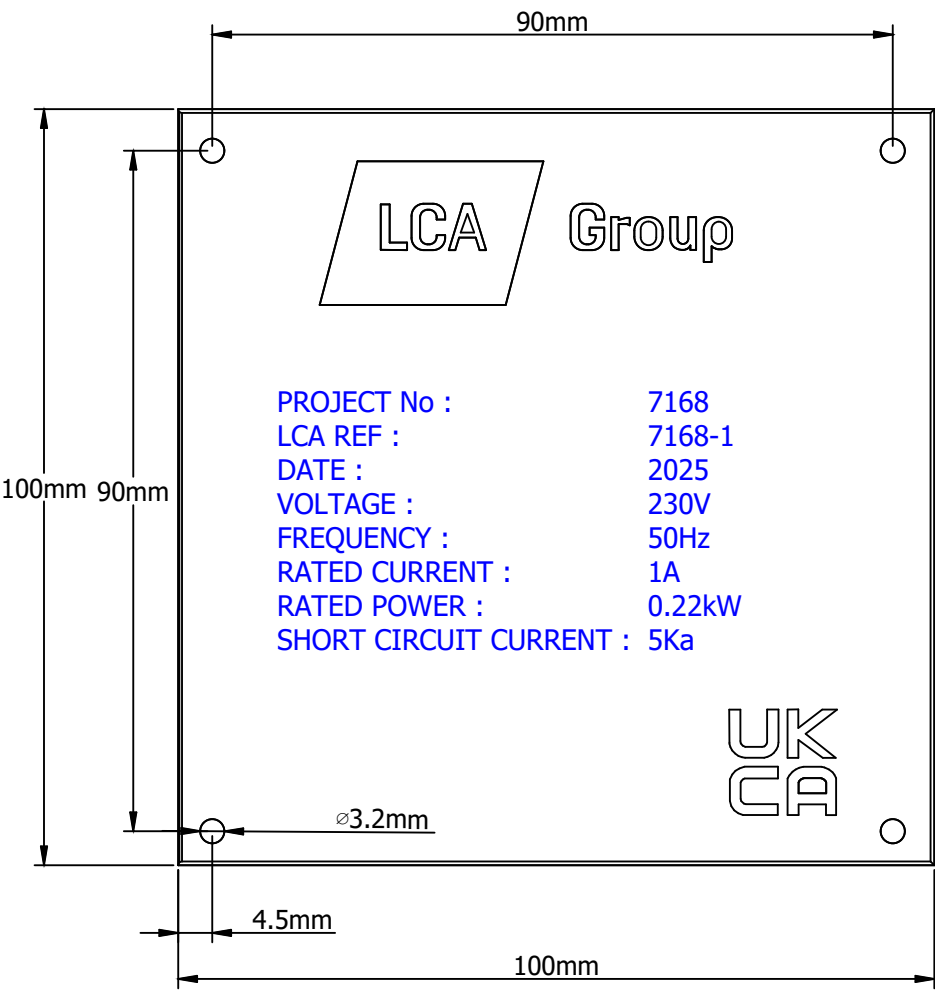

LCA PART No. CS00205  
DEVICE TAG: -U17  
WHITE, BLACK TEXT  
TEXT SIZE 3mm


SECURITY CLASSIFICATION : NONE

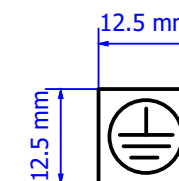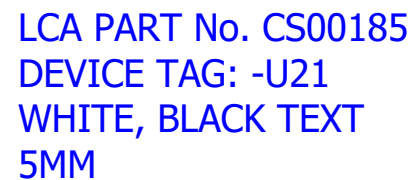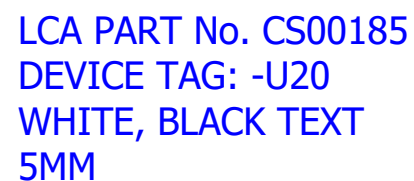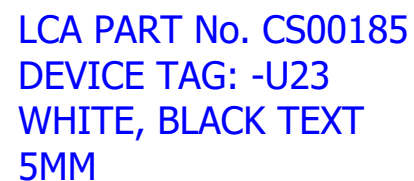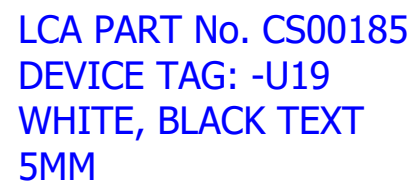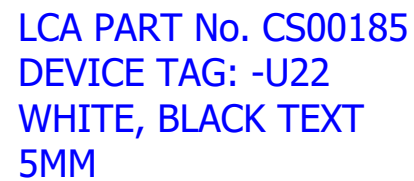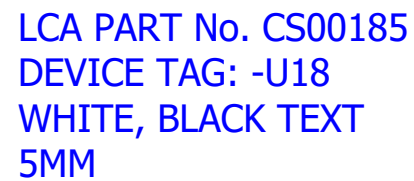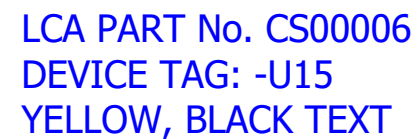


LCA PART No. 776-0939  
GREEN, BLACK TEXT


[illegible]

Protected by copyright. Passing on as well as reproduction of this document, its utilization and communication of its contents are prohibited in as far as not expressly permitted.

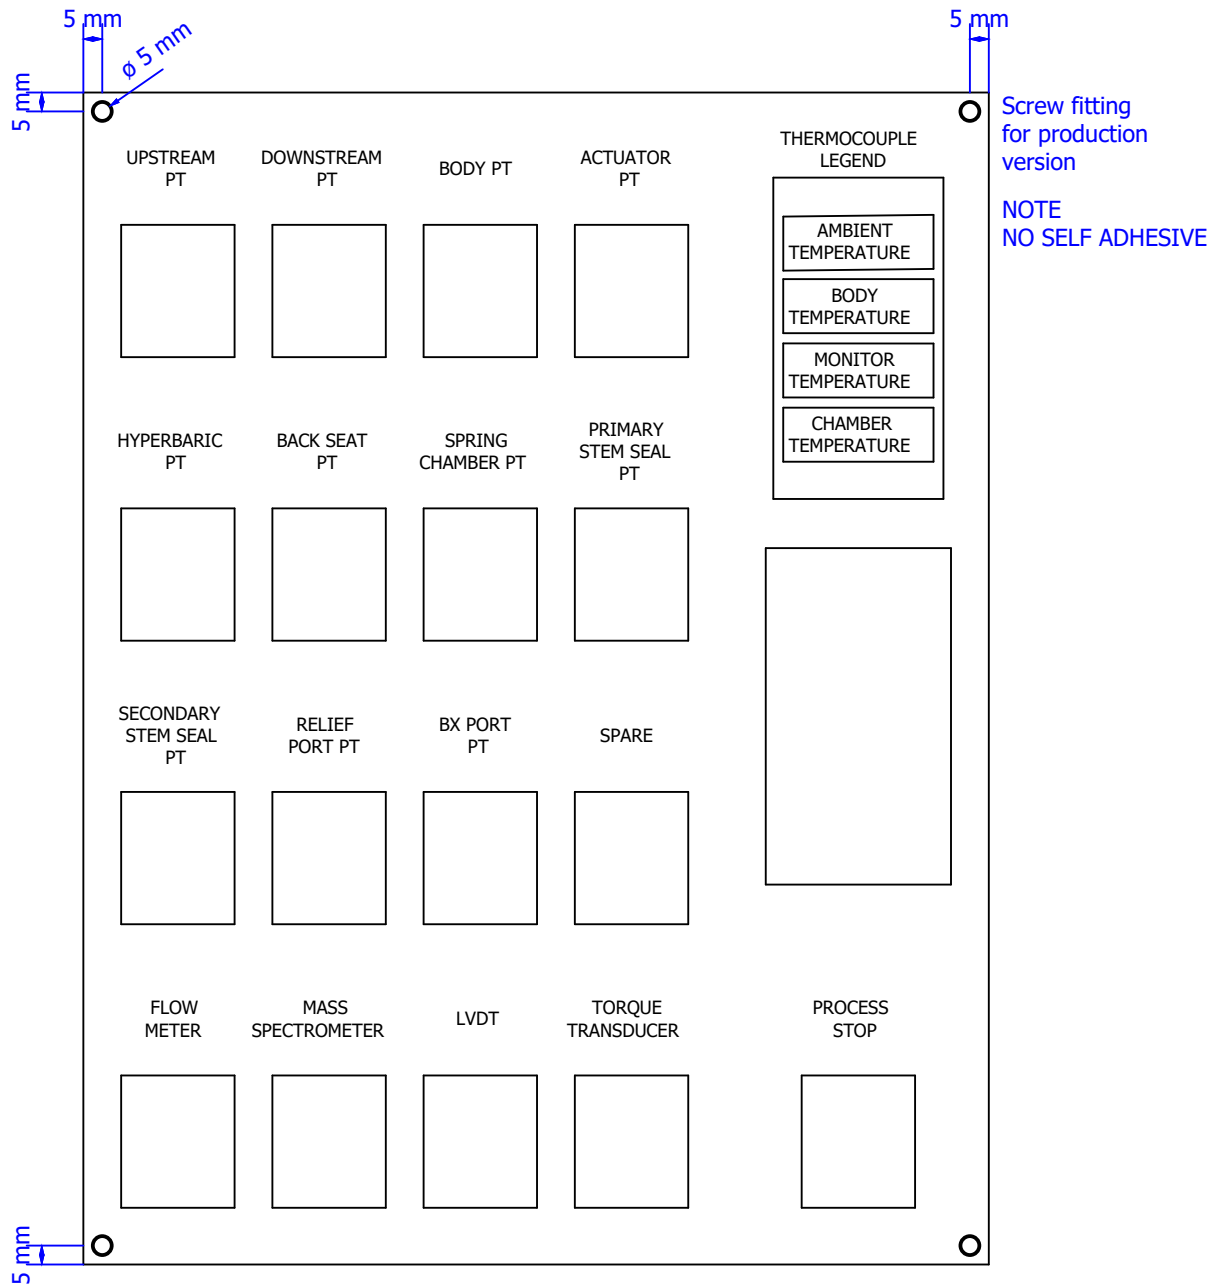

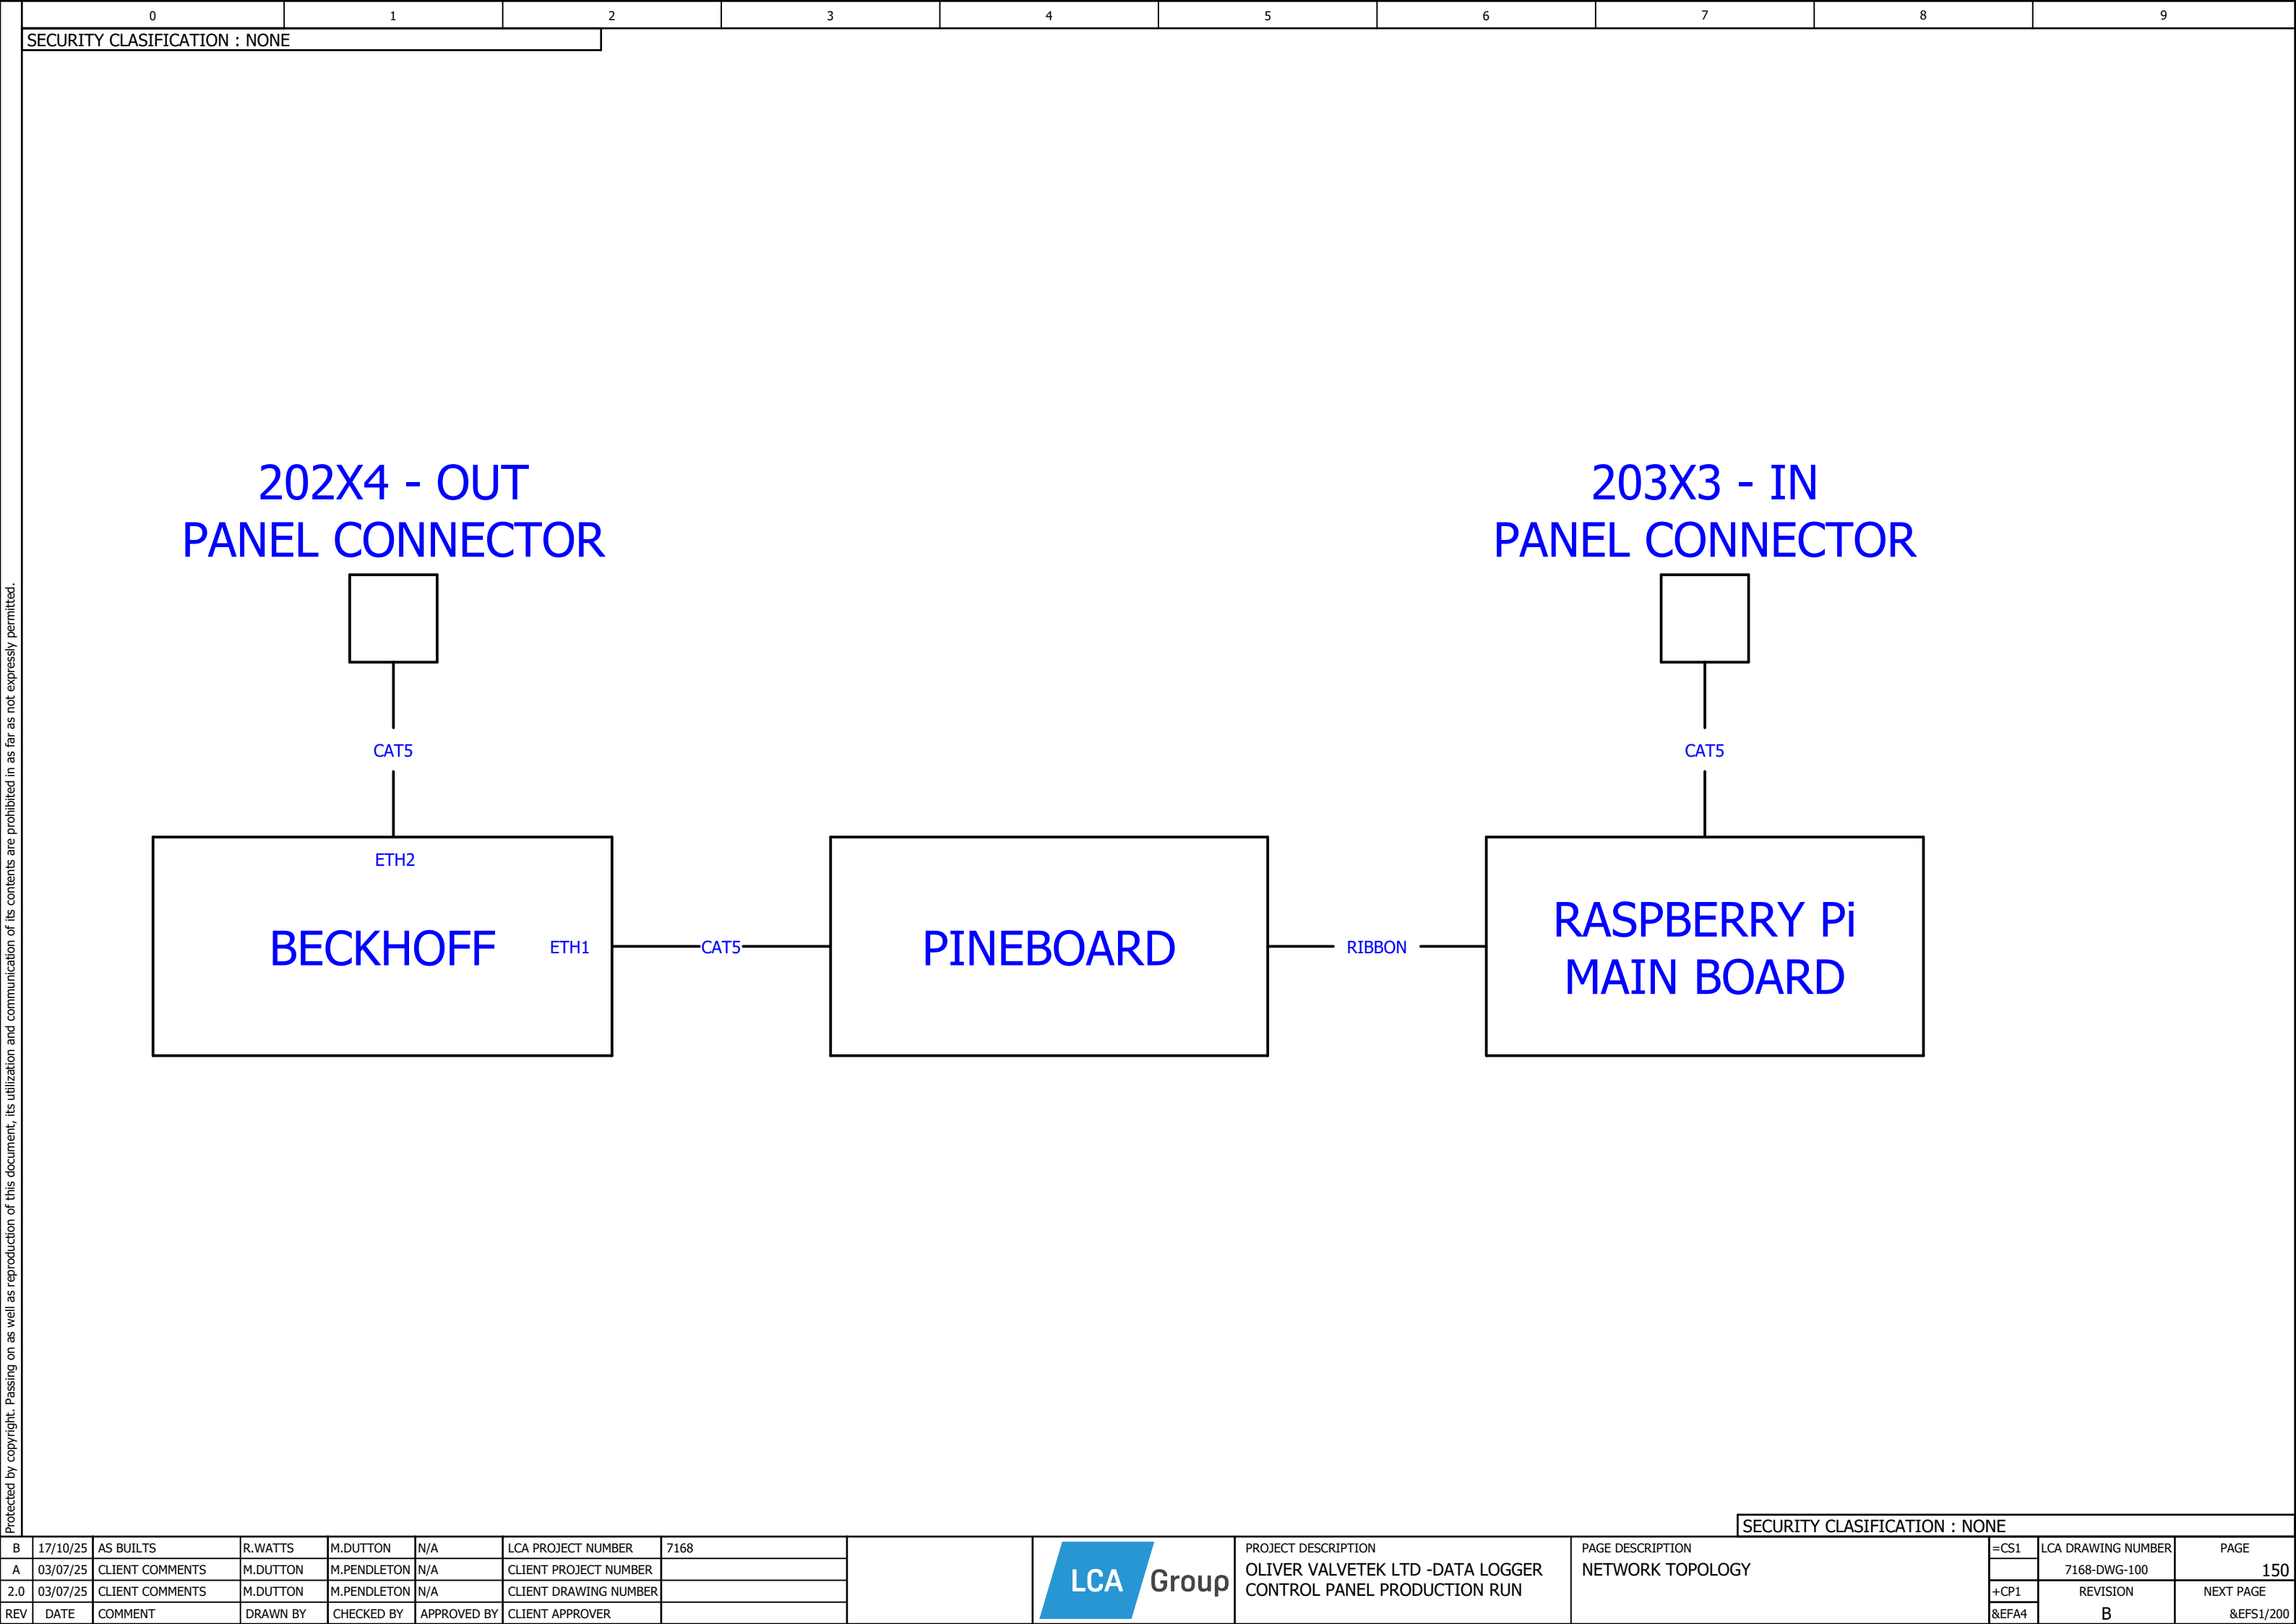

Protected by copyright. Passing on as well as reproduction of this document, its utilization and communication of its contents are prohibited in as far as not expressly permitted.

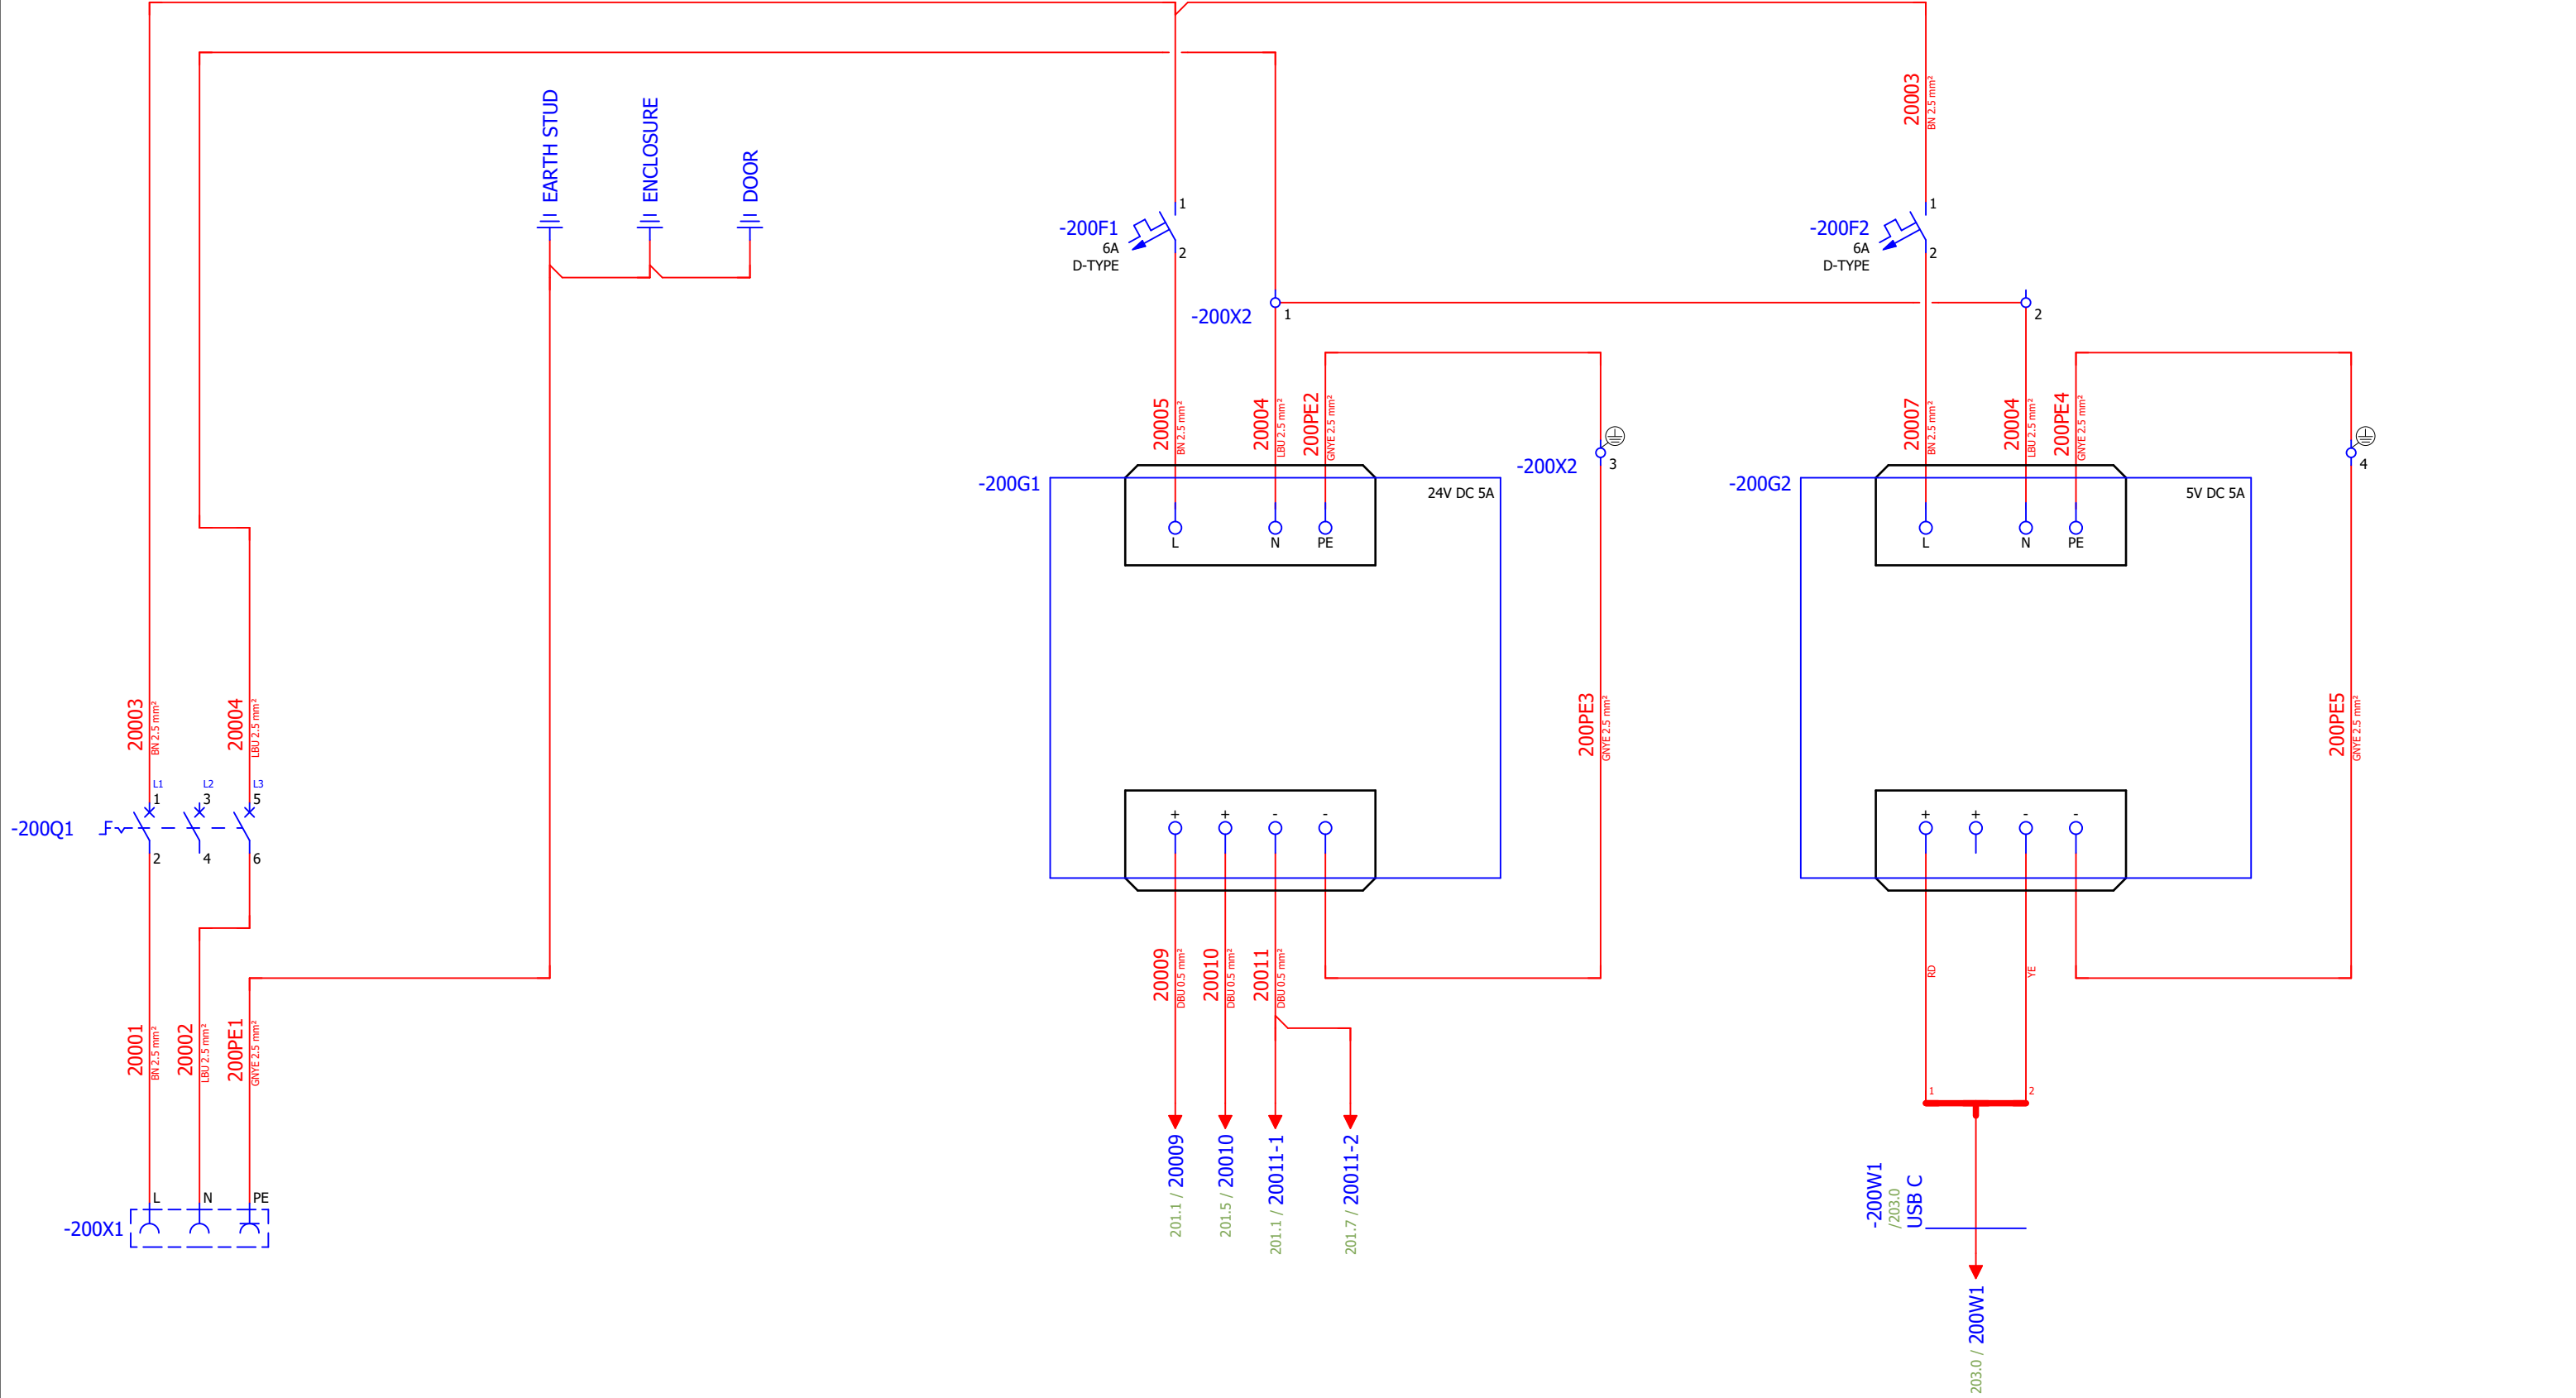

|     |          |                 |          |             |             |                       |      |
|-----|----------|-----------------|----------|-------------|-------------|-----------------------|------|
| B   | 17/10/25 | AS BUILTS       | R.WATTS  | M.DUTTON    | N/A         | LCA PROJECT NUMBER    | 7168 |
| A   | 03/07/25 | CLIENT COMMENTS | M.DUTTON | M.PENDLETON | N/A         | CLIENT PROJECT NUMBER |      |
| 2.0 | 03/07/25 | CLIENT COMMENTS | M.DUTTON | M.PENDLETON | N/A         | CLIENT DRAWING NUMBER |      |
| REV | DATE     | COMMENT         | DRAWN BY | CHECKED BY  | APPROVED BY | CLIENT APPROVER       |      |








PROJECT DESCRIPTION  
OLIVER VALVETEK LTD -DATA LOGGER  
CONTROL PANEL PRODUCTION RUN



PAGE DESCRIPTION  
INCOMER SECTION

|       |                    |           |
|-------|--------------------|-----------|
| =CS1  | LCA DRAWING NUMBER | PAGE      |
| +CP1  | 7168-DWG-100       | 200       |
| &EFS1 | REVISION           | NEXT PAGE |
|       | B                  | 201       |

Protected by copyright. Passing on as well as reproduction of this document, its utilization and communication of its contents are prohibited in as far as not expressly permitted.

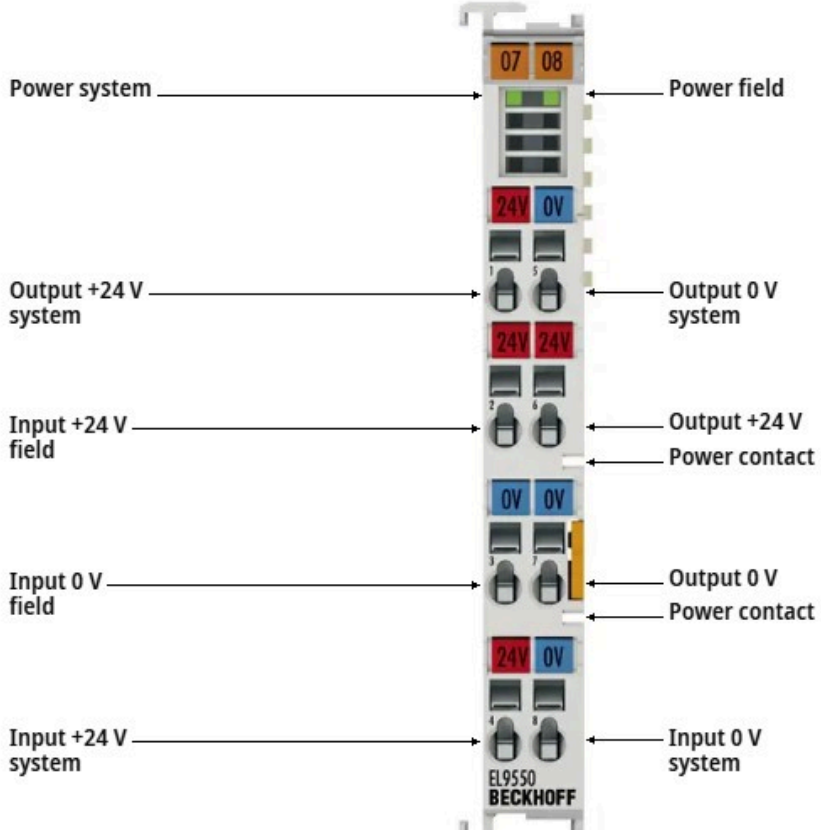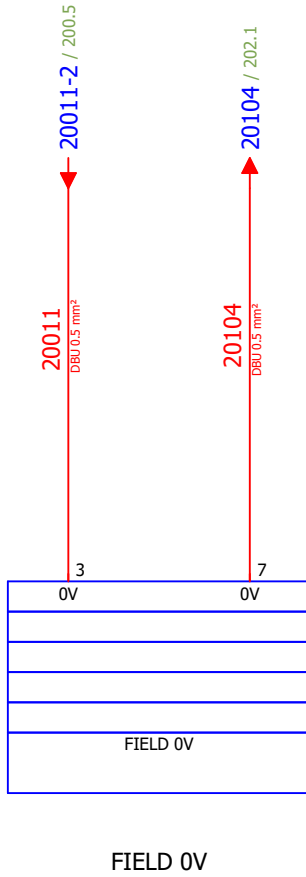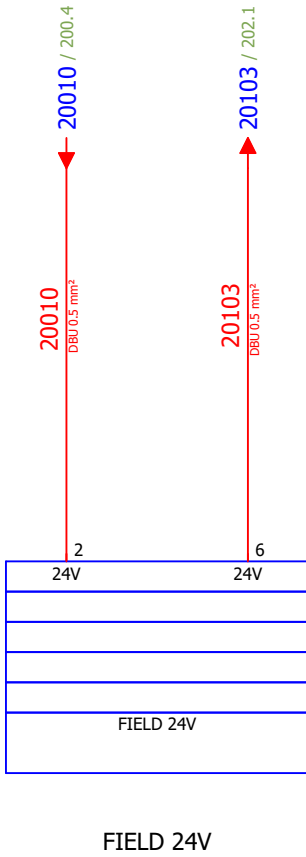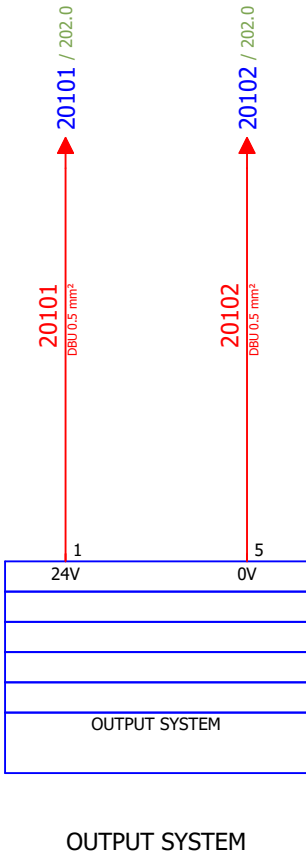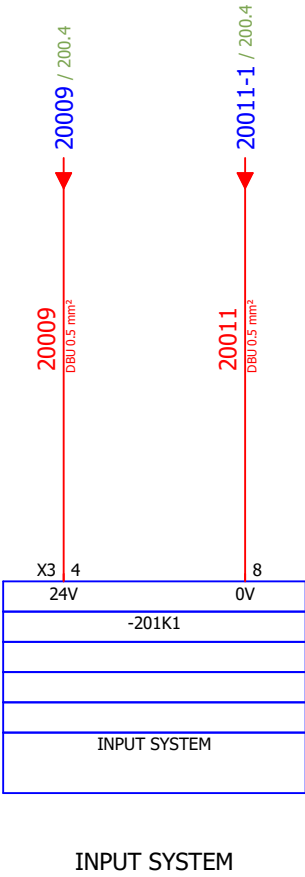




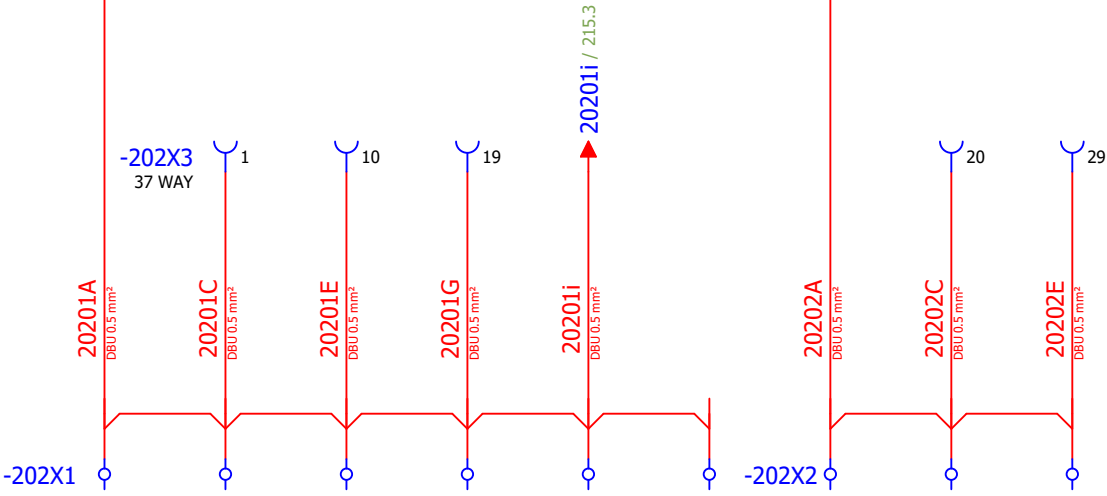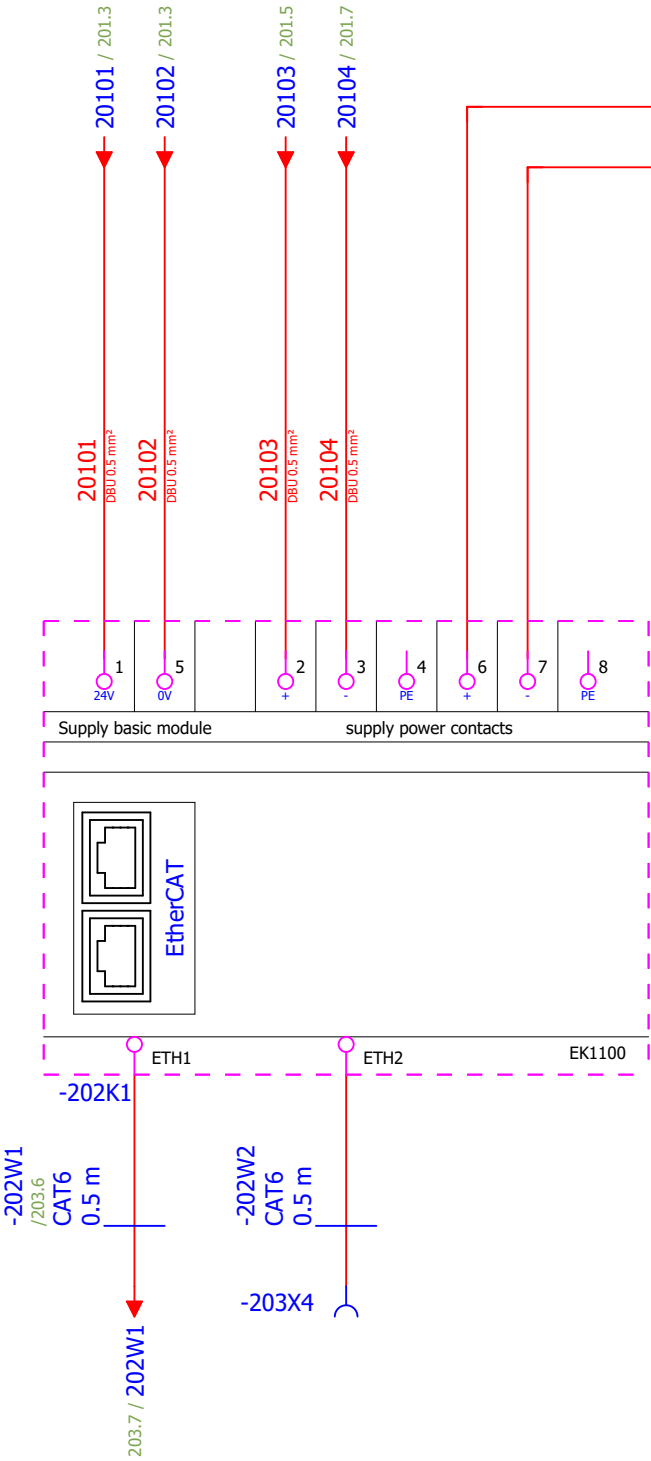

202X3

Protected by copyright. Passing on as well as reproduction of this document, its utilization and communication of its contents are prohibited in as far as not expressly permitted.

Protected by copyright. Passing on as well as reproduction of this document, its utilization and communication of its contents are prohibited in as far as not expressly permitted.


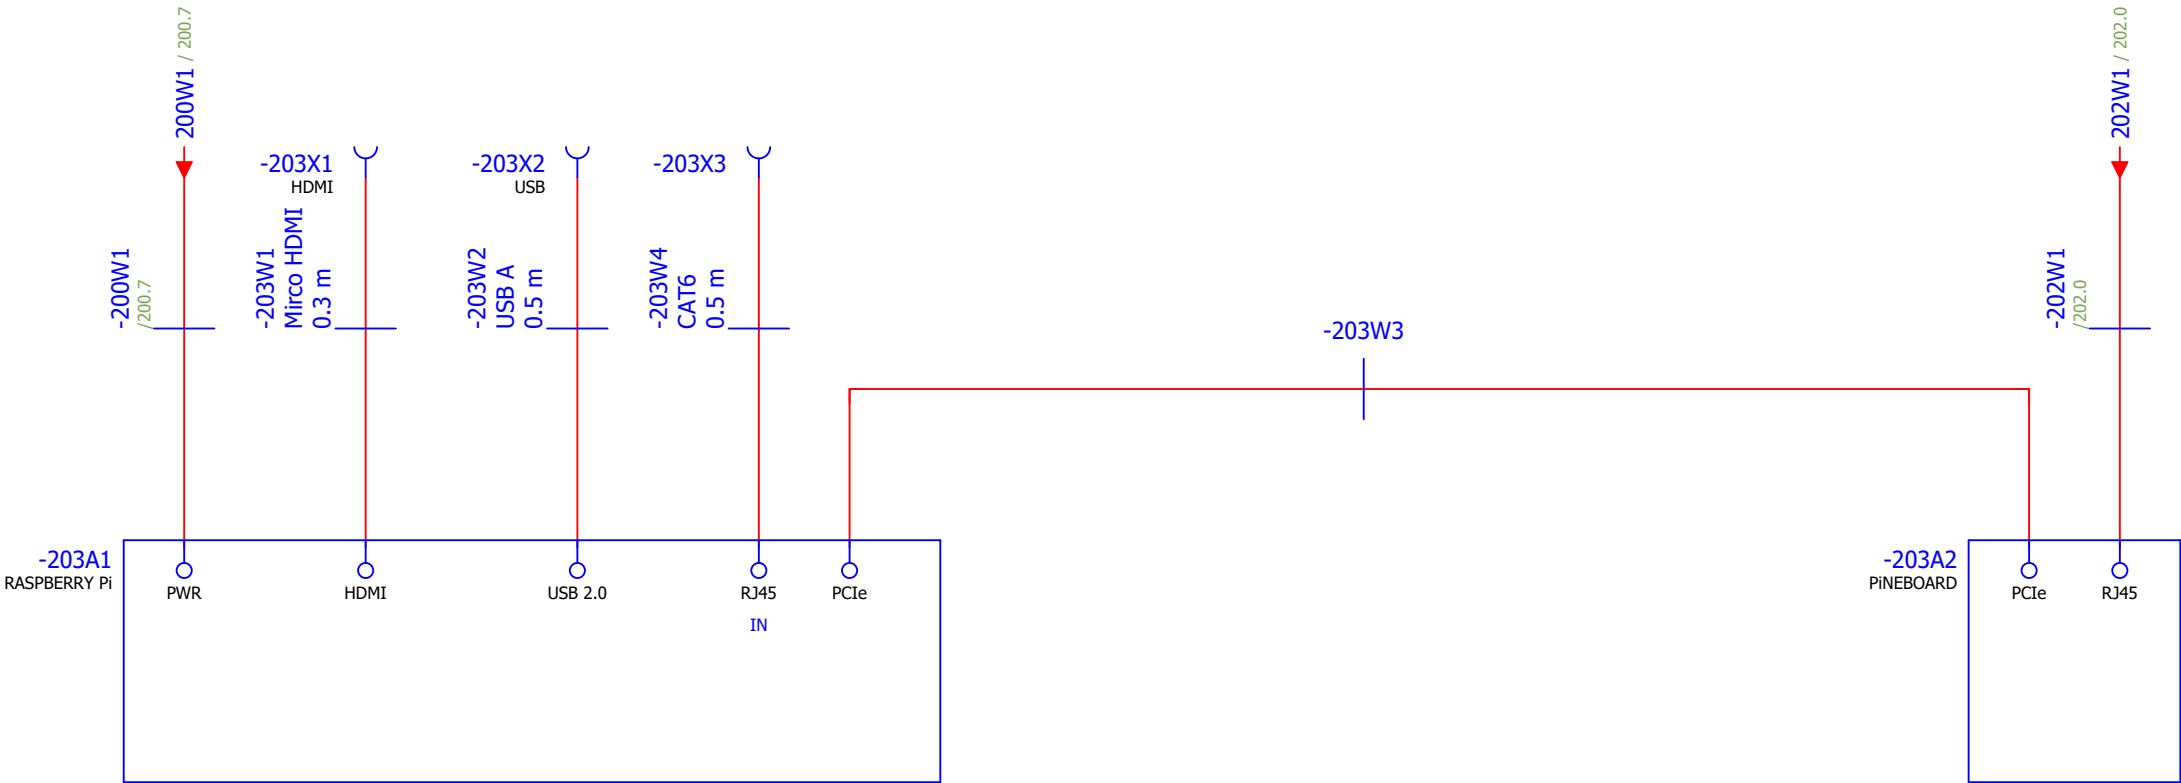


SECURITY CLASIFICATION : NONE



SECURITY CLASSIFICATION : NONE

Protected by copyright. Passing on as well as reproduction of this document, its utilization and communication of its contents are prohibited in as far as not expressly permitted.

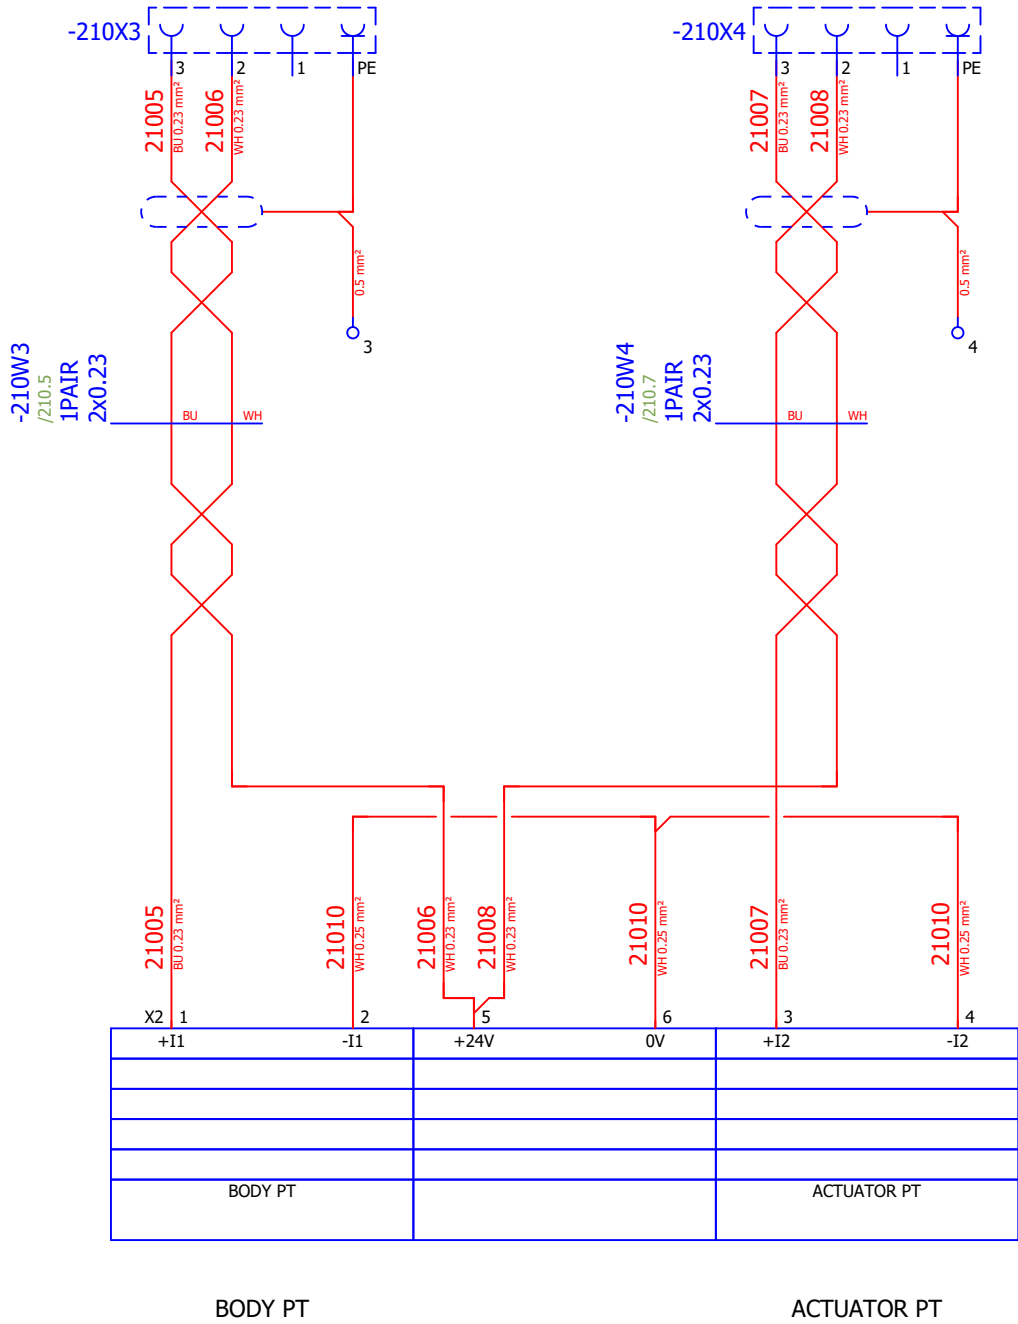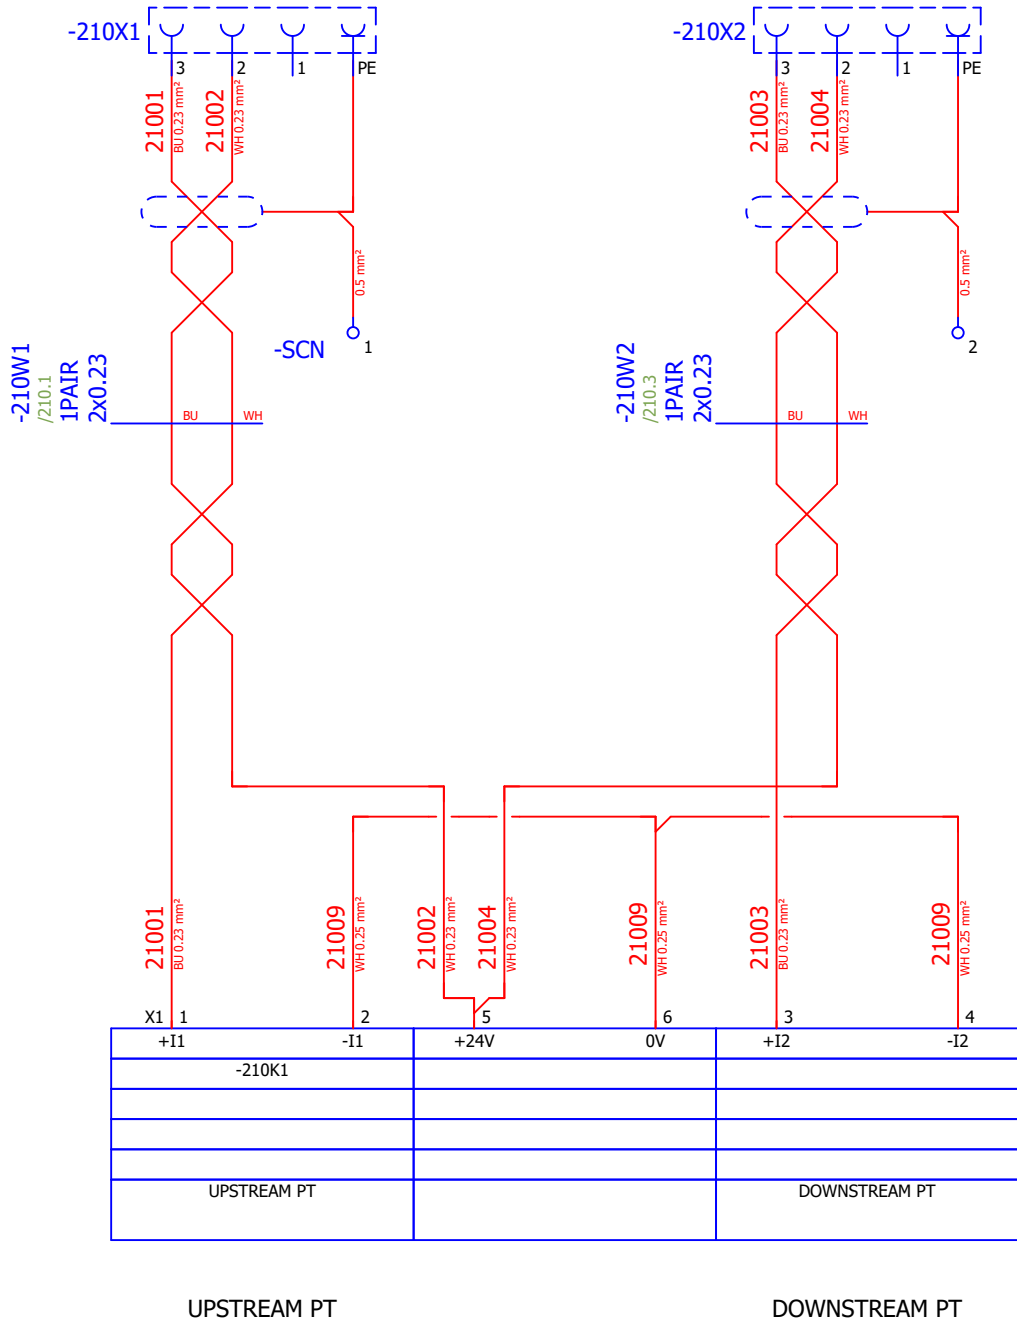

SECURITY CLASSIFICATION : NONE

|     |          |                 |          |             |             |                       |      |
|-----|----------|-----------------|----------|-------------|-------------|-----------------------|------|
| B   | 17/10/25 | AS BUILTS       | R.WATTS  | M.DUTTON    | N/A         | LCA PROJECT NUMBER    | 7168 |
| A   | 03/07/25 | CLIENT COMMENTS | M.DUTTON | M.PENDLETON | N/A         | CLIENT PROJECT NUMBER |      |
| 2.0 | 03/07/25 | CLIENT COMMENTS | M.DUTTON | M.PENDLETON | N/A         | CLIENT DRAWING NUMBER |      |
| REV | DATE     | COMMENT         | DRAWN BY | CHECKED BY  | APPROVED BY | CLIENT APPROVER       |      |




PROJECT DESCRIPTION  
OLIVER VALVETEK LTD -DATA LOGGER  
CONTROL PANEL PRODUCTION RUN

PAGE DESCRIPTION  
ANALOGUE INPUT 1 CHANNELS 0-3


|       |                    |           |
|-------|--------------------|-----------|
| =CS1  | LCA DRAWING NUMBER | PAGE      |
| +CP1  | 7168-DWG-100       | 210       |
| &EFS1 | REVISION           | NEXT PAGE |
|       | B                  | 211       |

Protected by copyright. Passing on as well as reproduction of this document, its utilization and communication of its contents are prohibited in as far as not expressly permitted.

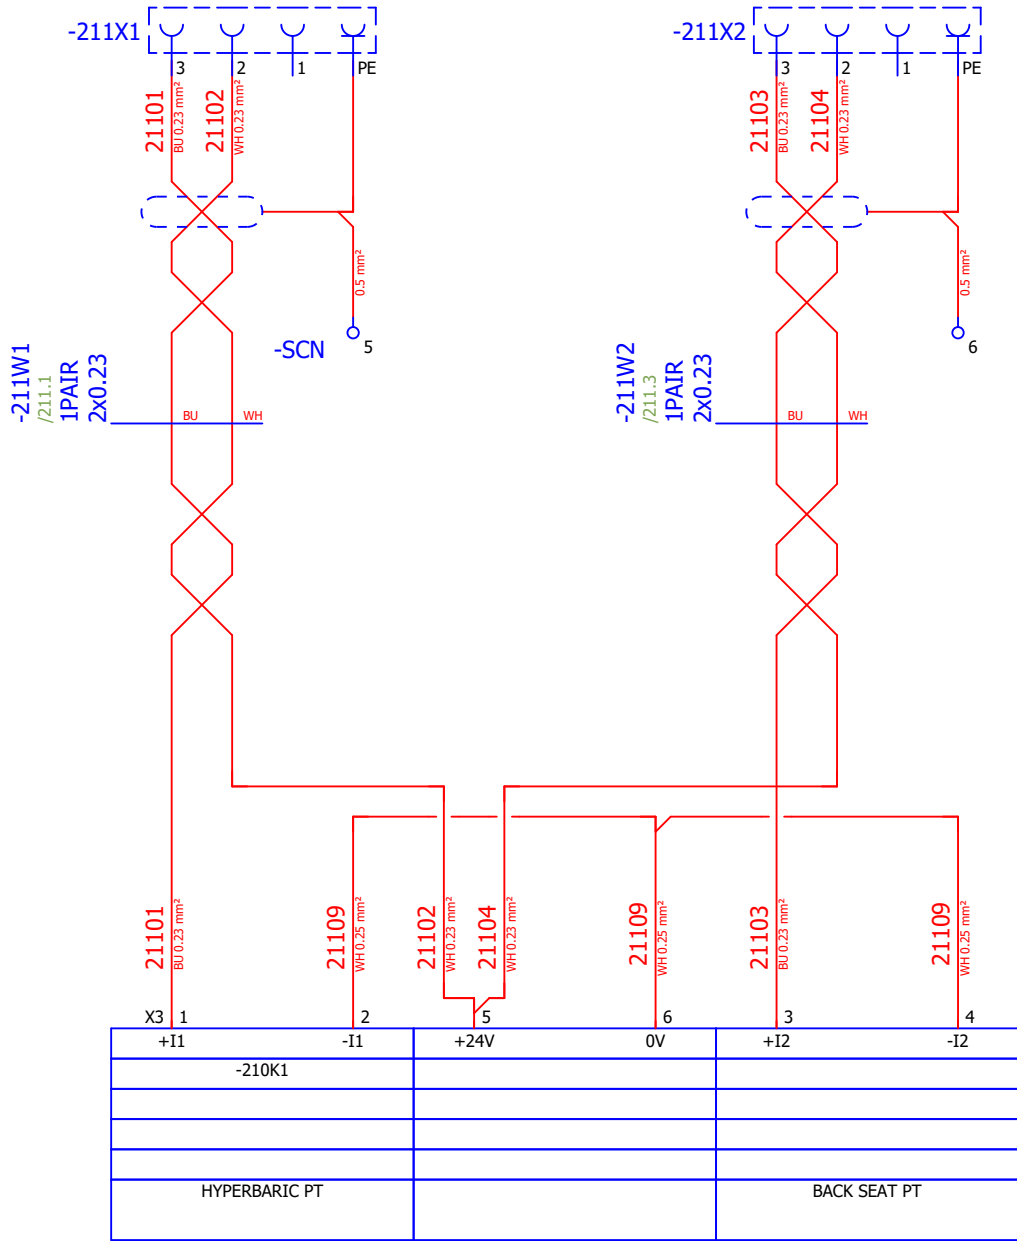

HYPERBARIC PT

BACK SEAT PT

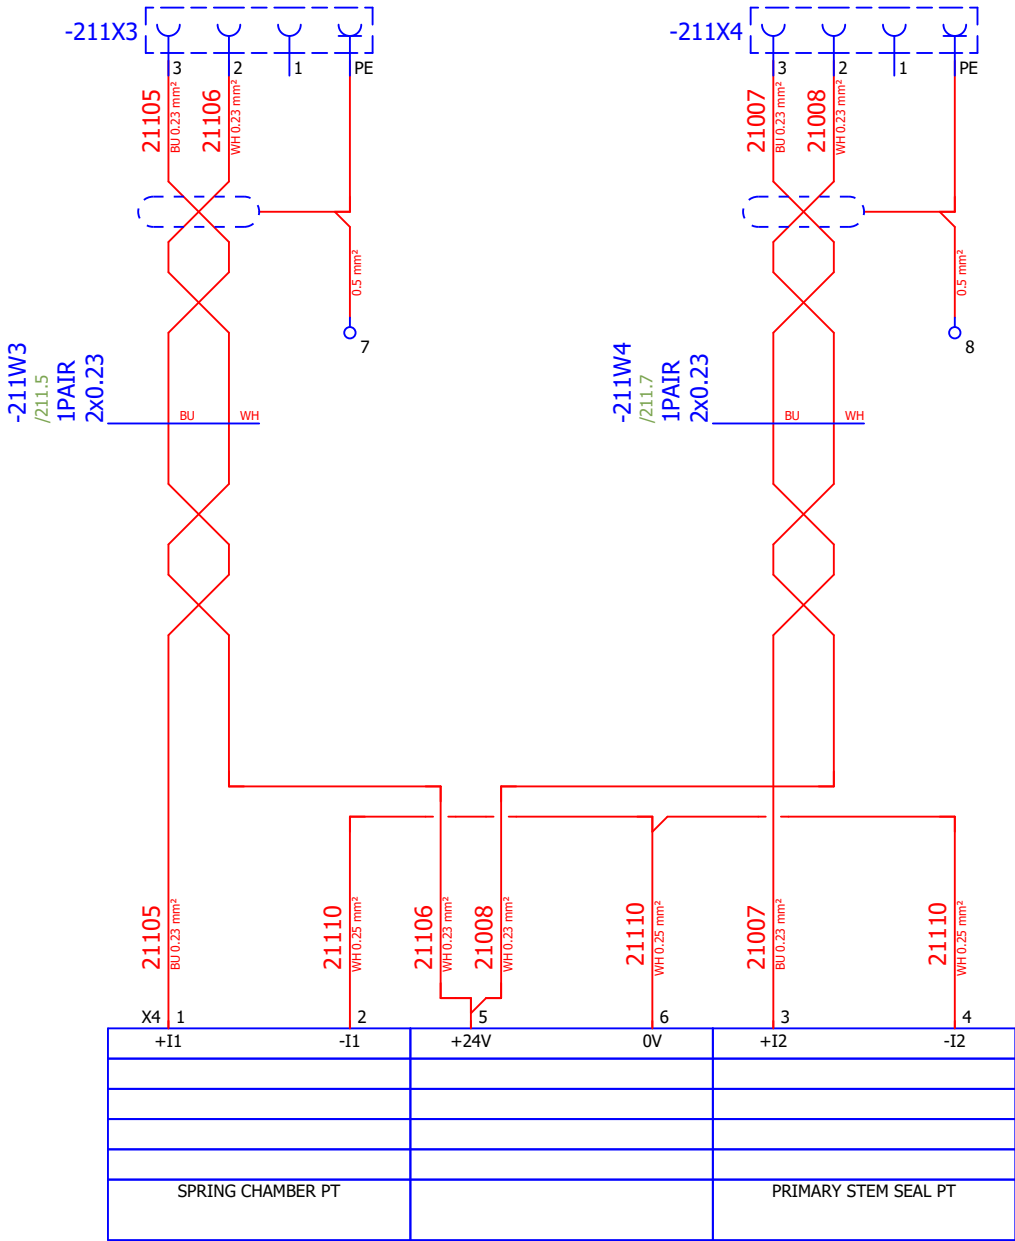

SPRING CHAMBER PT

PRIMARY STEM SEAL PT

|     |          |                 |          |             |             |                       |      |
|-----|----------|-----------------|----------|-------------|-------------|-----------------------|------|
| B   | 17/10/25 | AS BUILTS       | R.WATTS  | M.DUTTON    | N/A         | LCA PROJECT NUMBER    | 7168 |
| A   | 03/07/25 | CLIENT COMMENTS | M.DUTTON | M.PENDLETON | N/A         | CLIENT PROJECT NUMBER |      |
| 2.0 | 03/07/25 | CLIENT COMMENTS | M.DUTTON | M.PENDLETON | N/A         | CLIENT DRAWING NUMBER |      |
| REV | DATE     | COMMENT         | DRAWN BY | CHECKED BY  | APPROVED BY | CLIENT APPROVER       |      |




PROJECT DESCRIPTION  
OLIVER VALVETEK LTD -DATA LOGGER  
CONTROL PANEL PRODUCTION RUN

PAGE DESCRIPTION  
ANALOGUE INPUT 1 CHANNELS 4-7


|       |                    |           |
|-------|--------------------|-----------|
| =CS1  | LCA DRAWING NUMBER | PAGE      |
| +CP1  | 7168-DWG-100       | 211       |
| &EFS1 | REVISION           | NEXT PAGE |
|       | B                  | 212       |

Protected by copyright. Passing on as well as reproduction of this document, its utilization and communication of its contents are prohibited in as far as not expressly permitted.

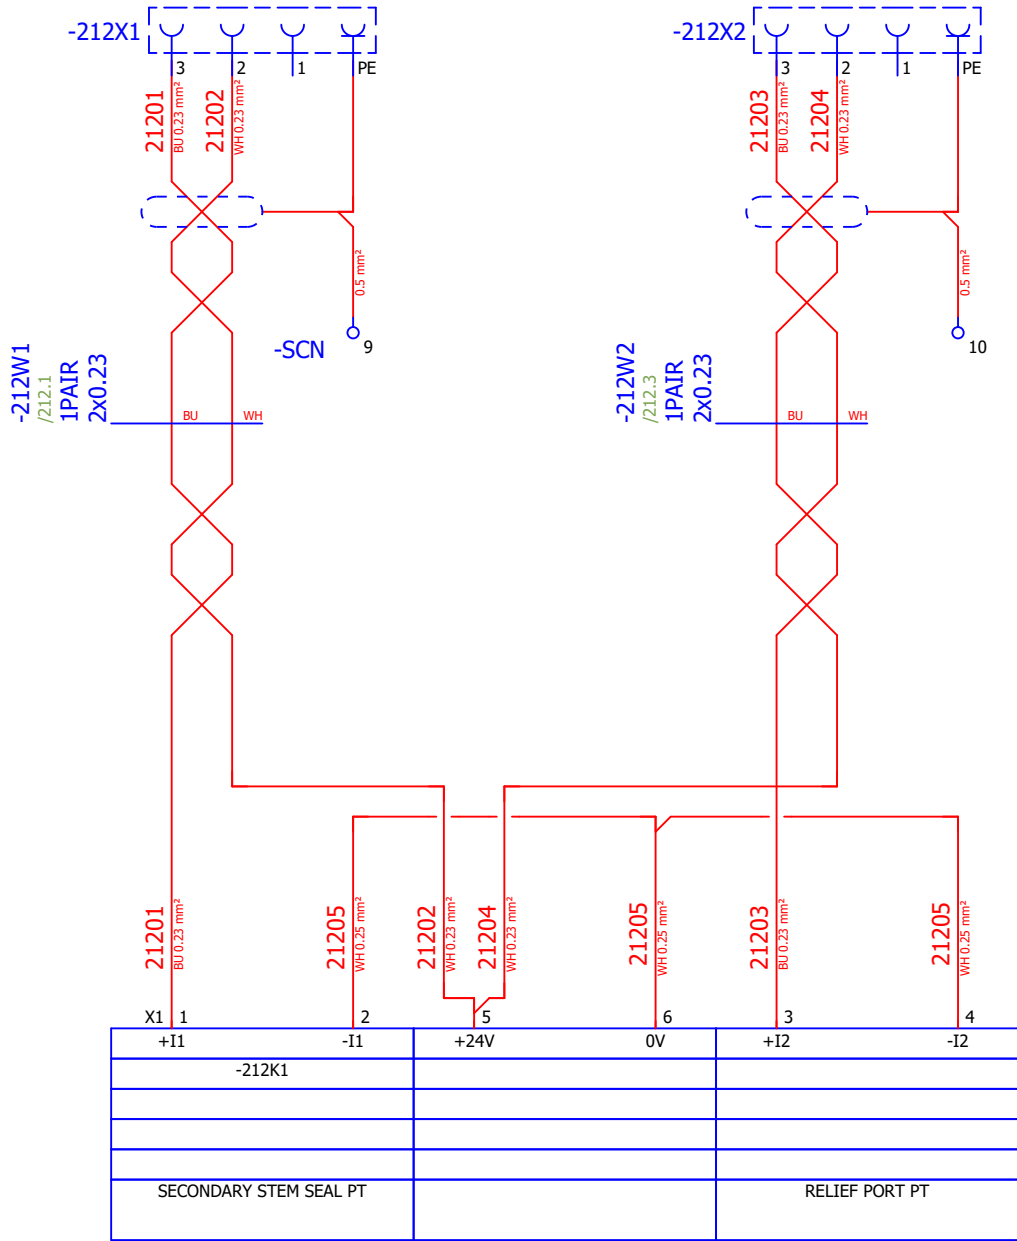

SECONDARY STEM SEAL PT



RELIEF PORT PT

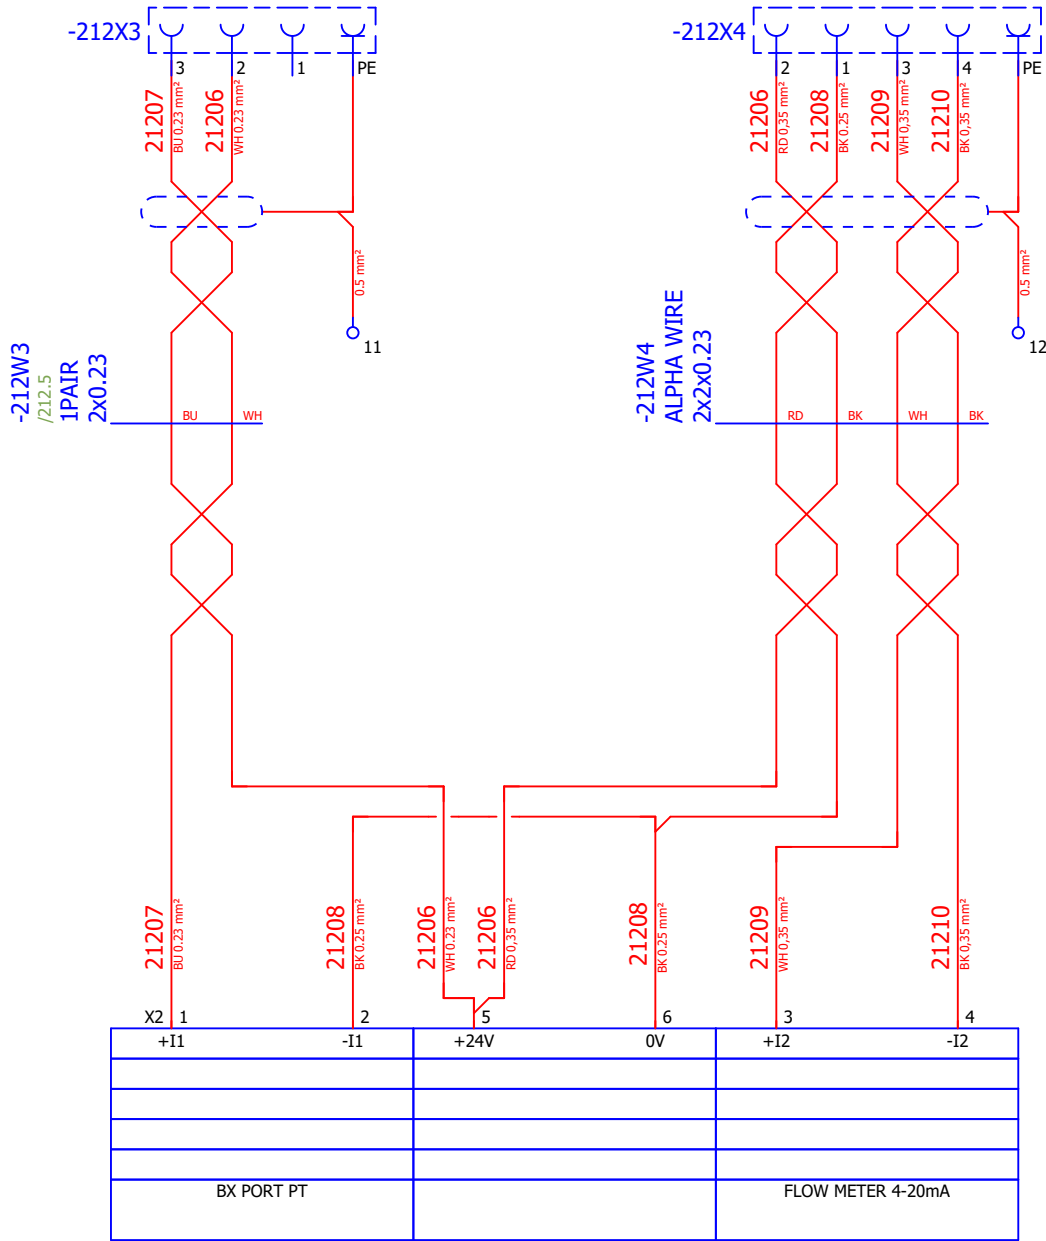


BX PORT PT

FLOW METER 4-20mA


Protected by copyright. Passing on as well as reproduction of this document, its utilization and communication of its contents are prohibited in as far as not expressly permitted.

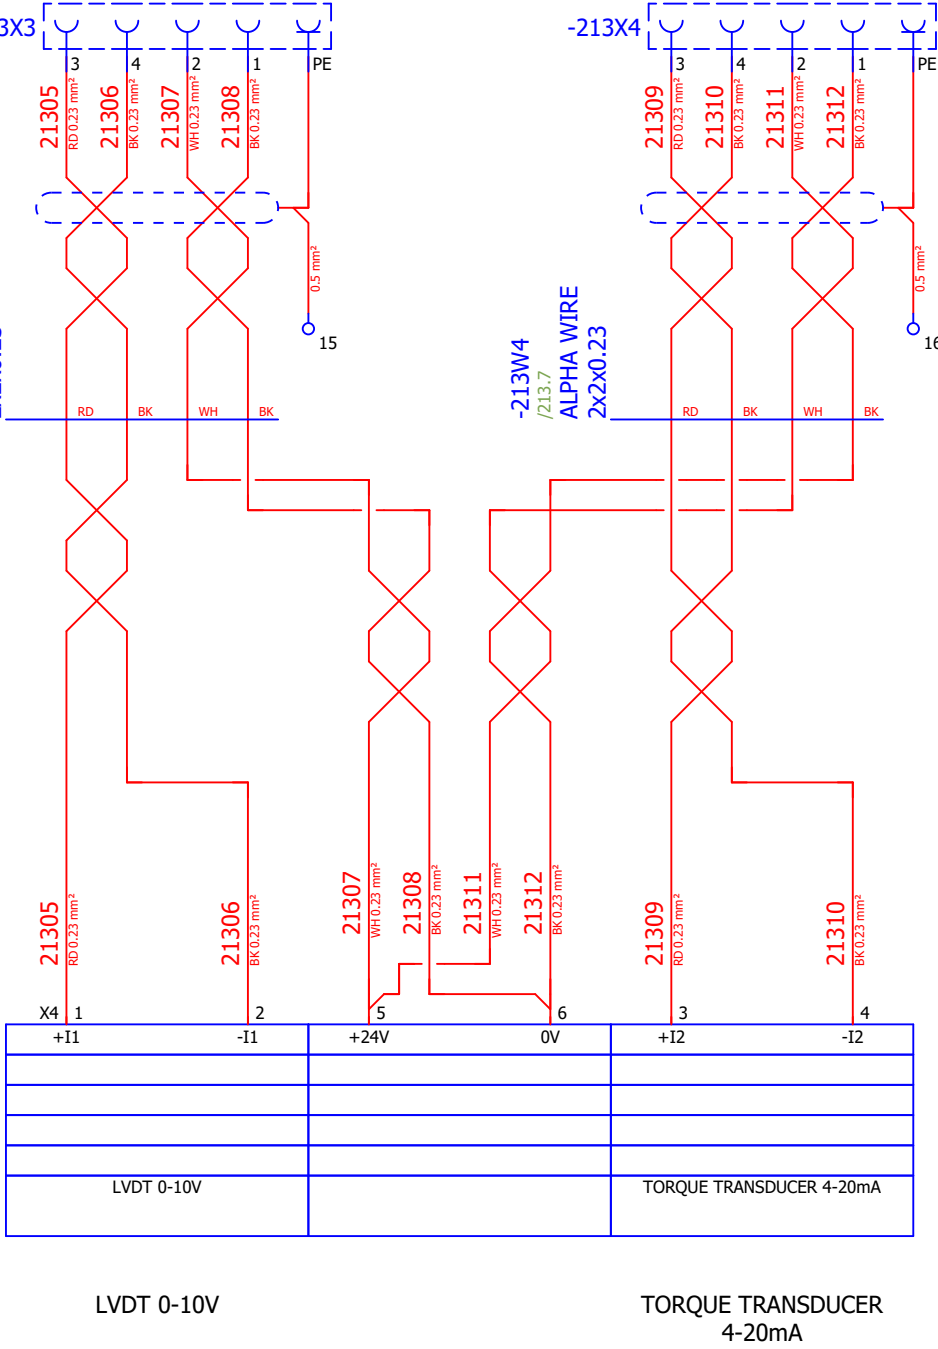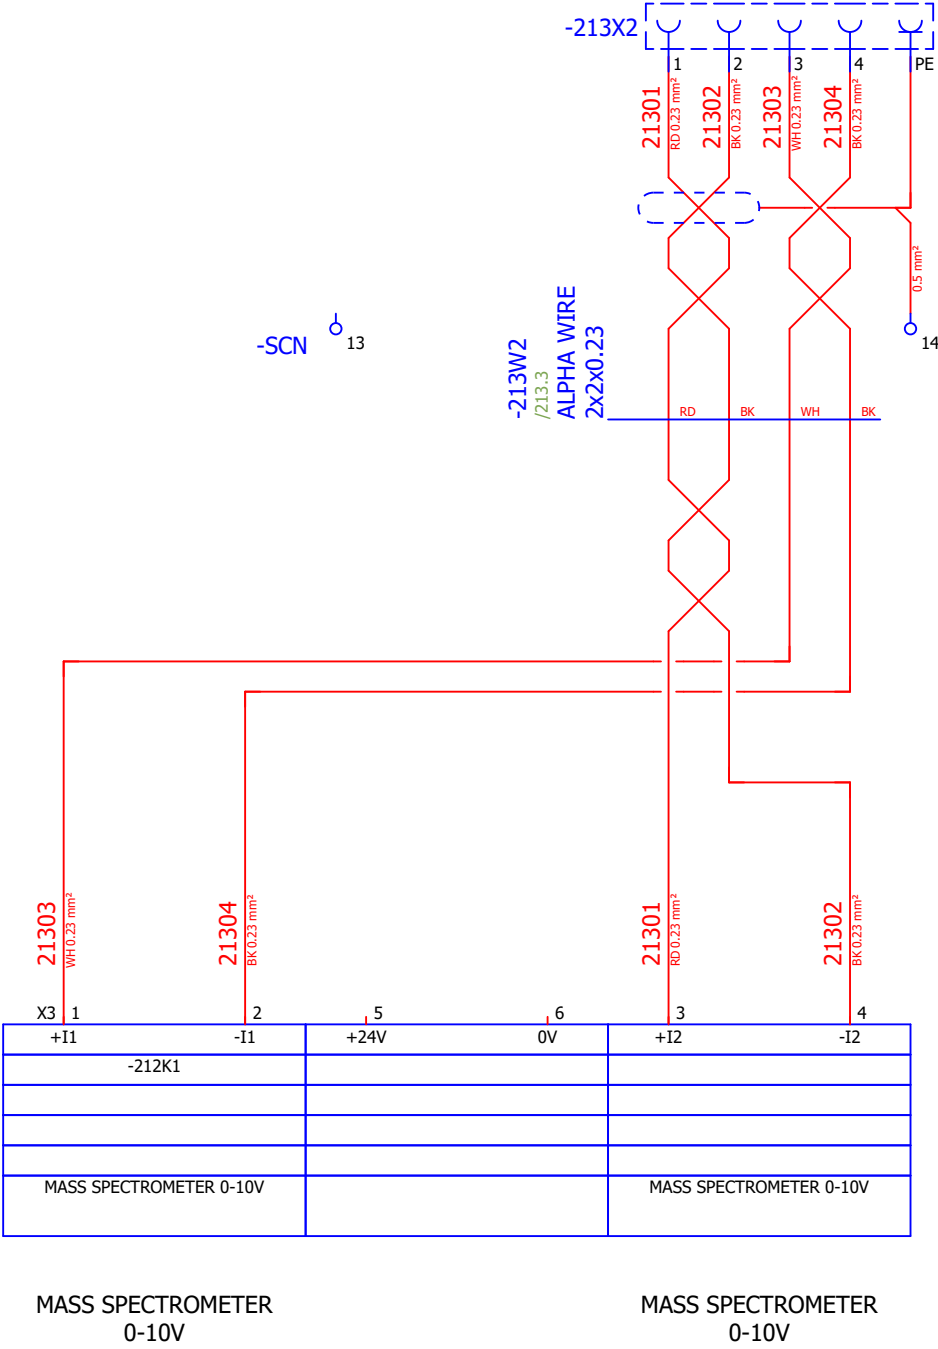


Protected by copyright. Passing on as well as reproduction of this document, its utilization and communication of its contents are prohibited in as far as not expressly permitted.

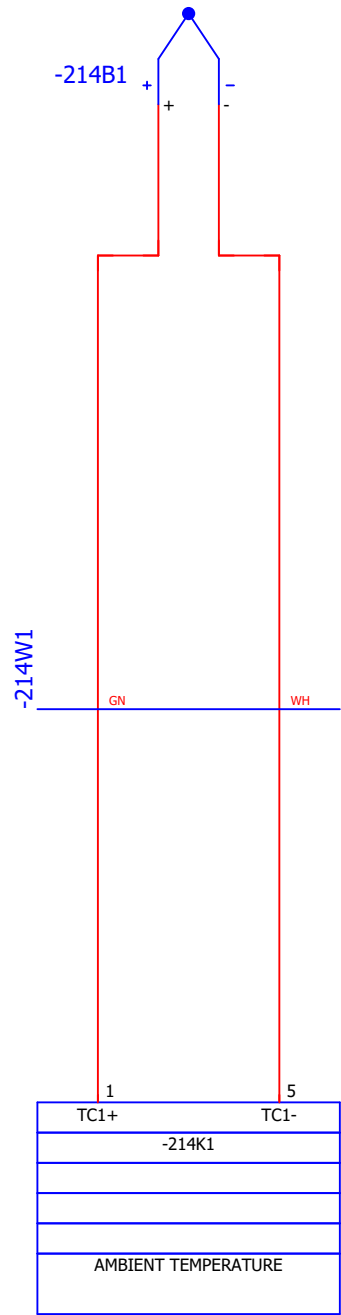


AMBIENT TEMPERATURE

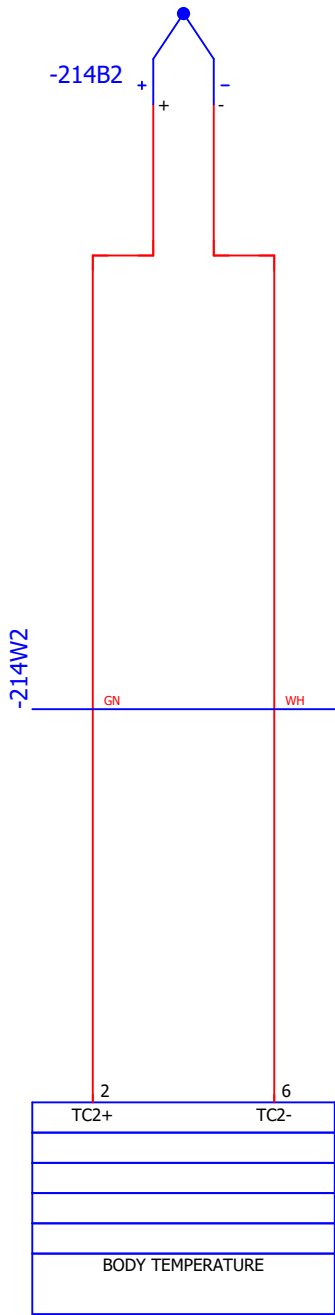

BODY TEMPERATURE

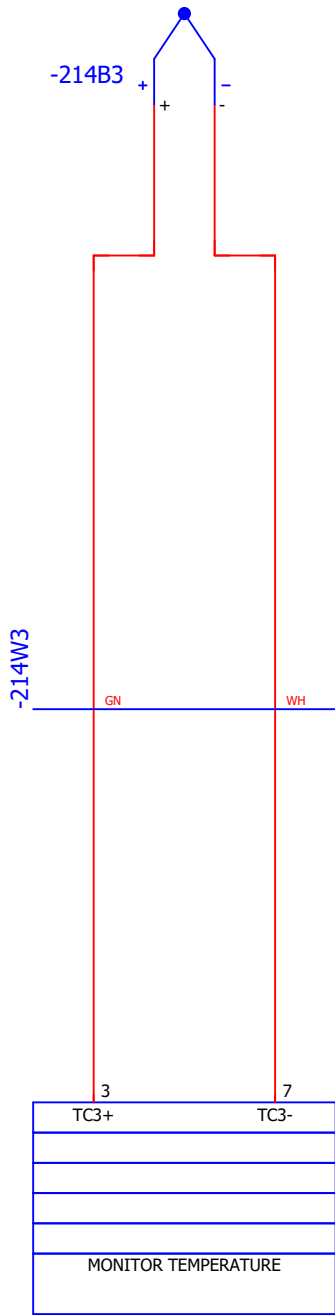

MONITOR TEMPERATURE

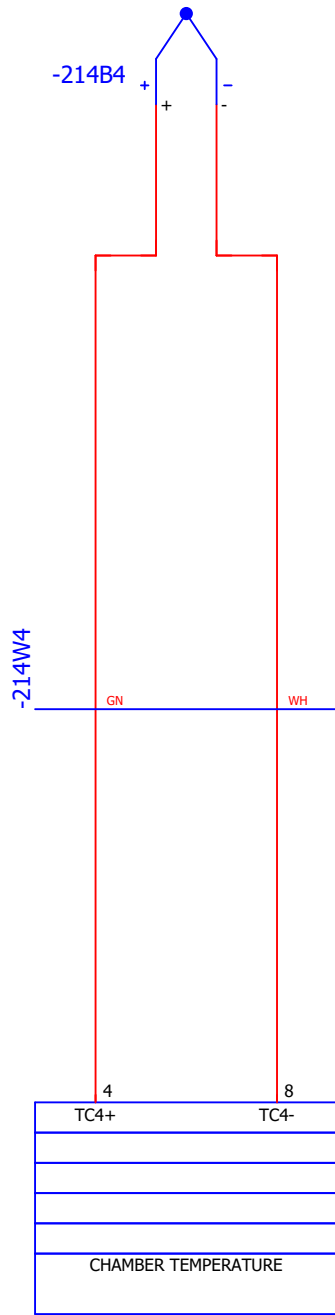


CHAMBER TEMPERATURE


SECURITY CLASSIFICATION : NONE

| 1                      | 2                       | 3            | 4     | 5     | 6     | 7     | 8     |
|------------------------|-------------------------|--------------|-------|-------|-------|-------|-------|
| I1                     | I2                      | I3           | I4    | I5    | I6    | I7    | I8    |
| -215K1                 |                         |              |       |       |       |       |       |
|                        |                         |              |       |       |       |       |       |
| PNEUMTIC OPEN POSITION | PNEUMTIC CLOSE POSITION | PROCESS STOP | SPARE | SPARE | SPARE | SPARE | SPARE |




SECURITY CLASSIFICATION : NONE

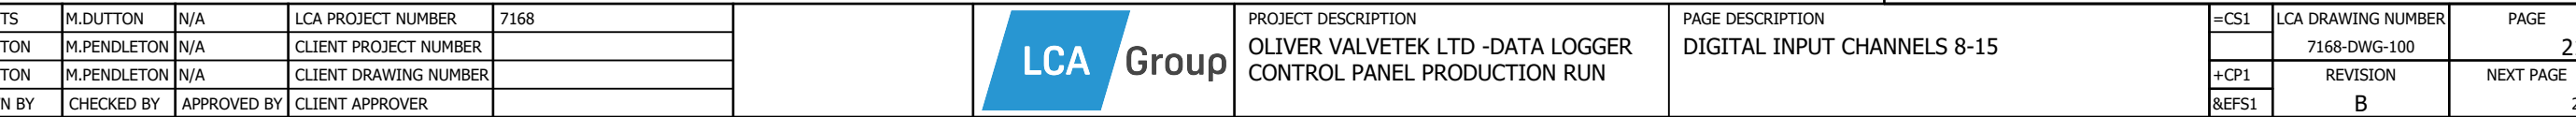

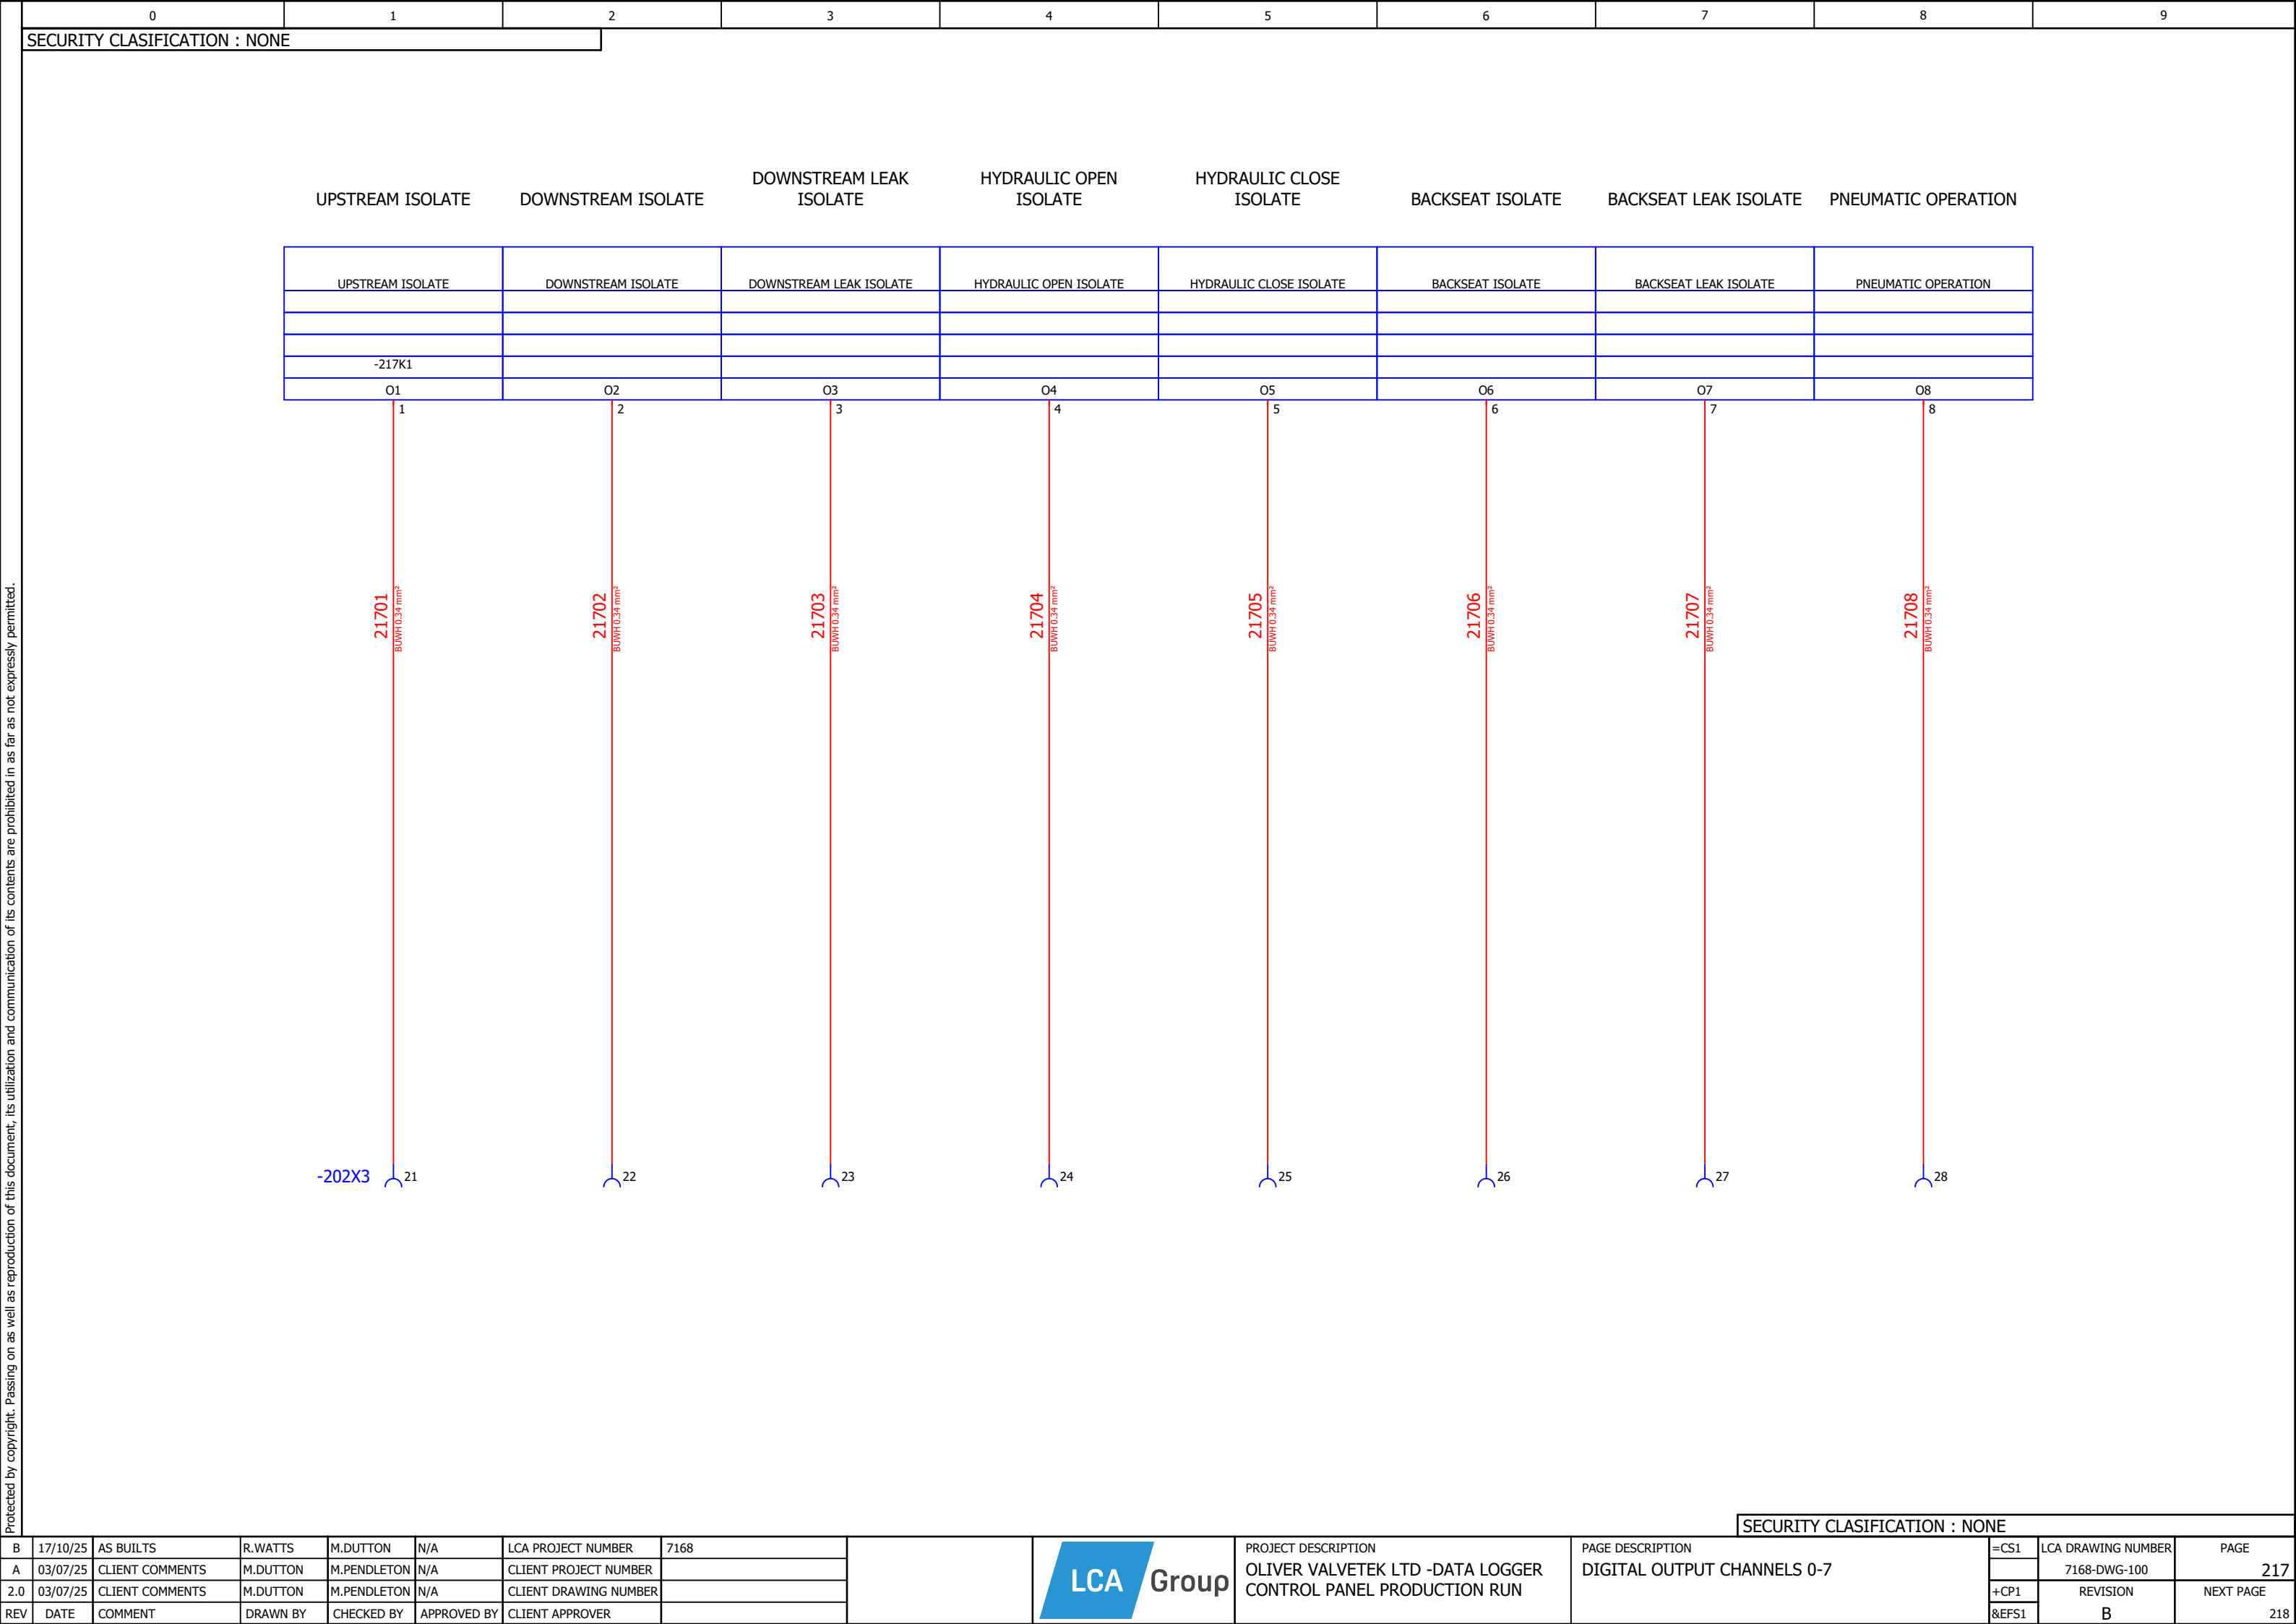

Protected by copyright. Passing on as well as reproduction of this document, its utilization and communication of its contents are prohibited in as far as not expressly permitted.



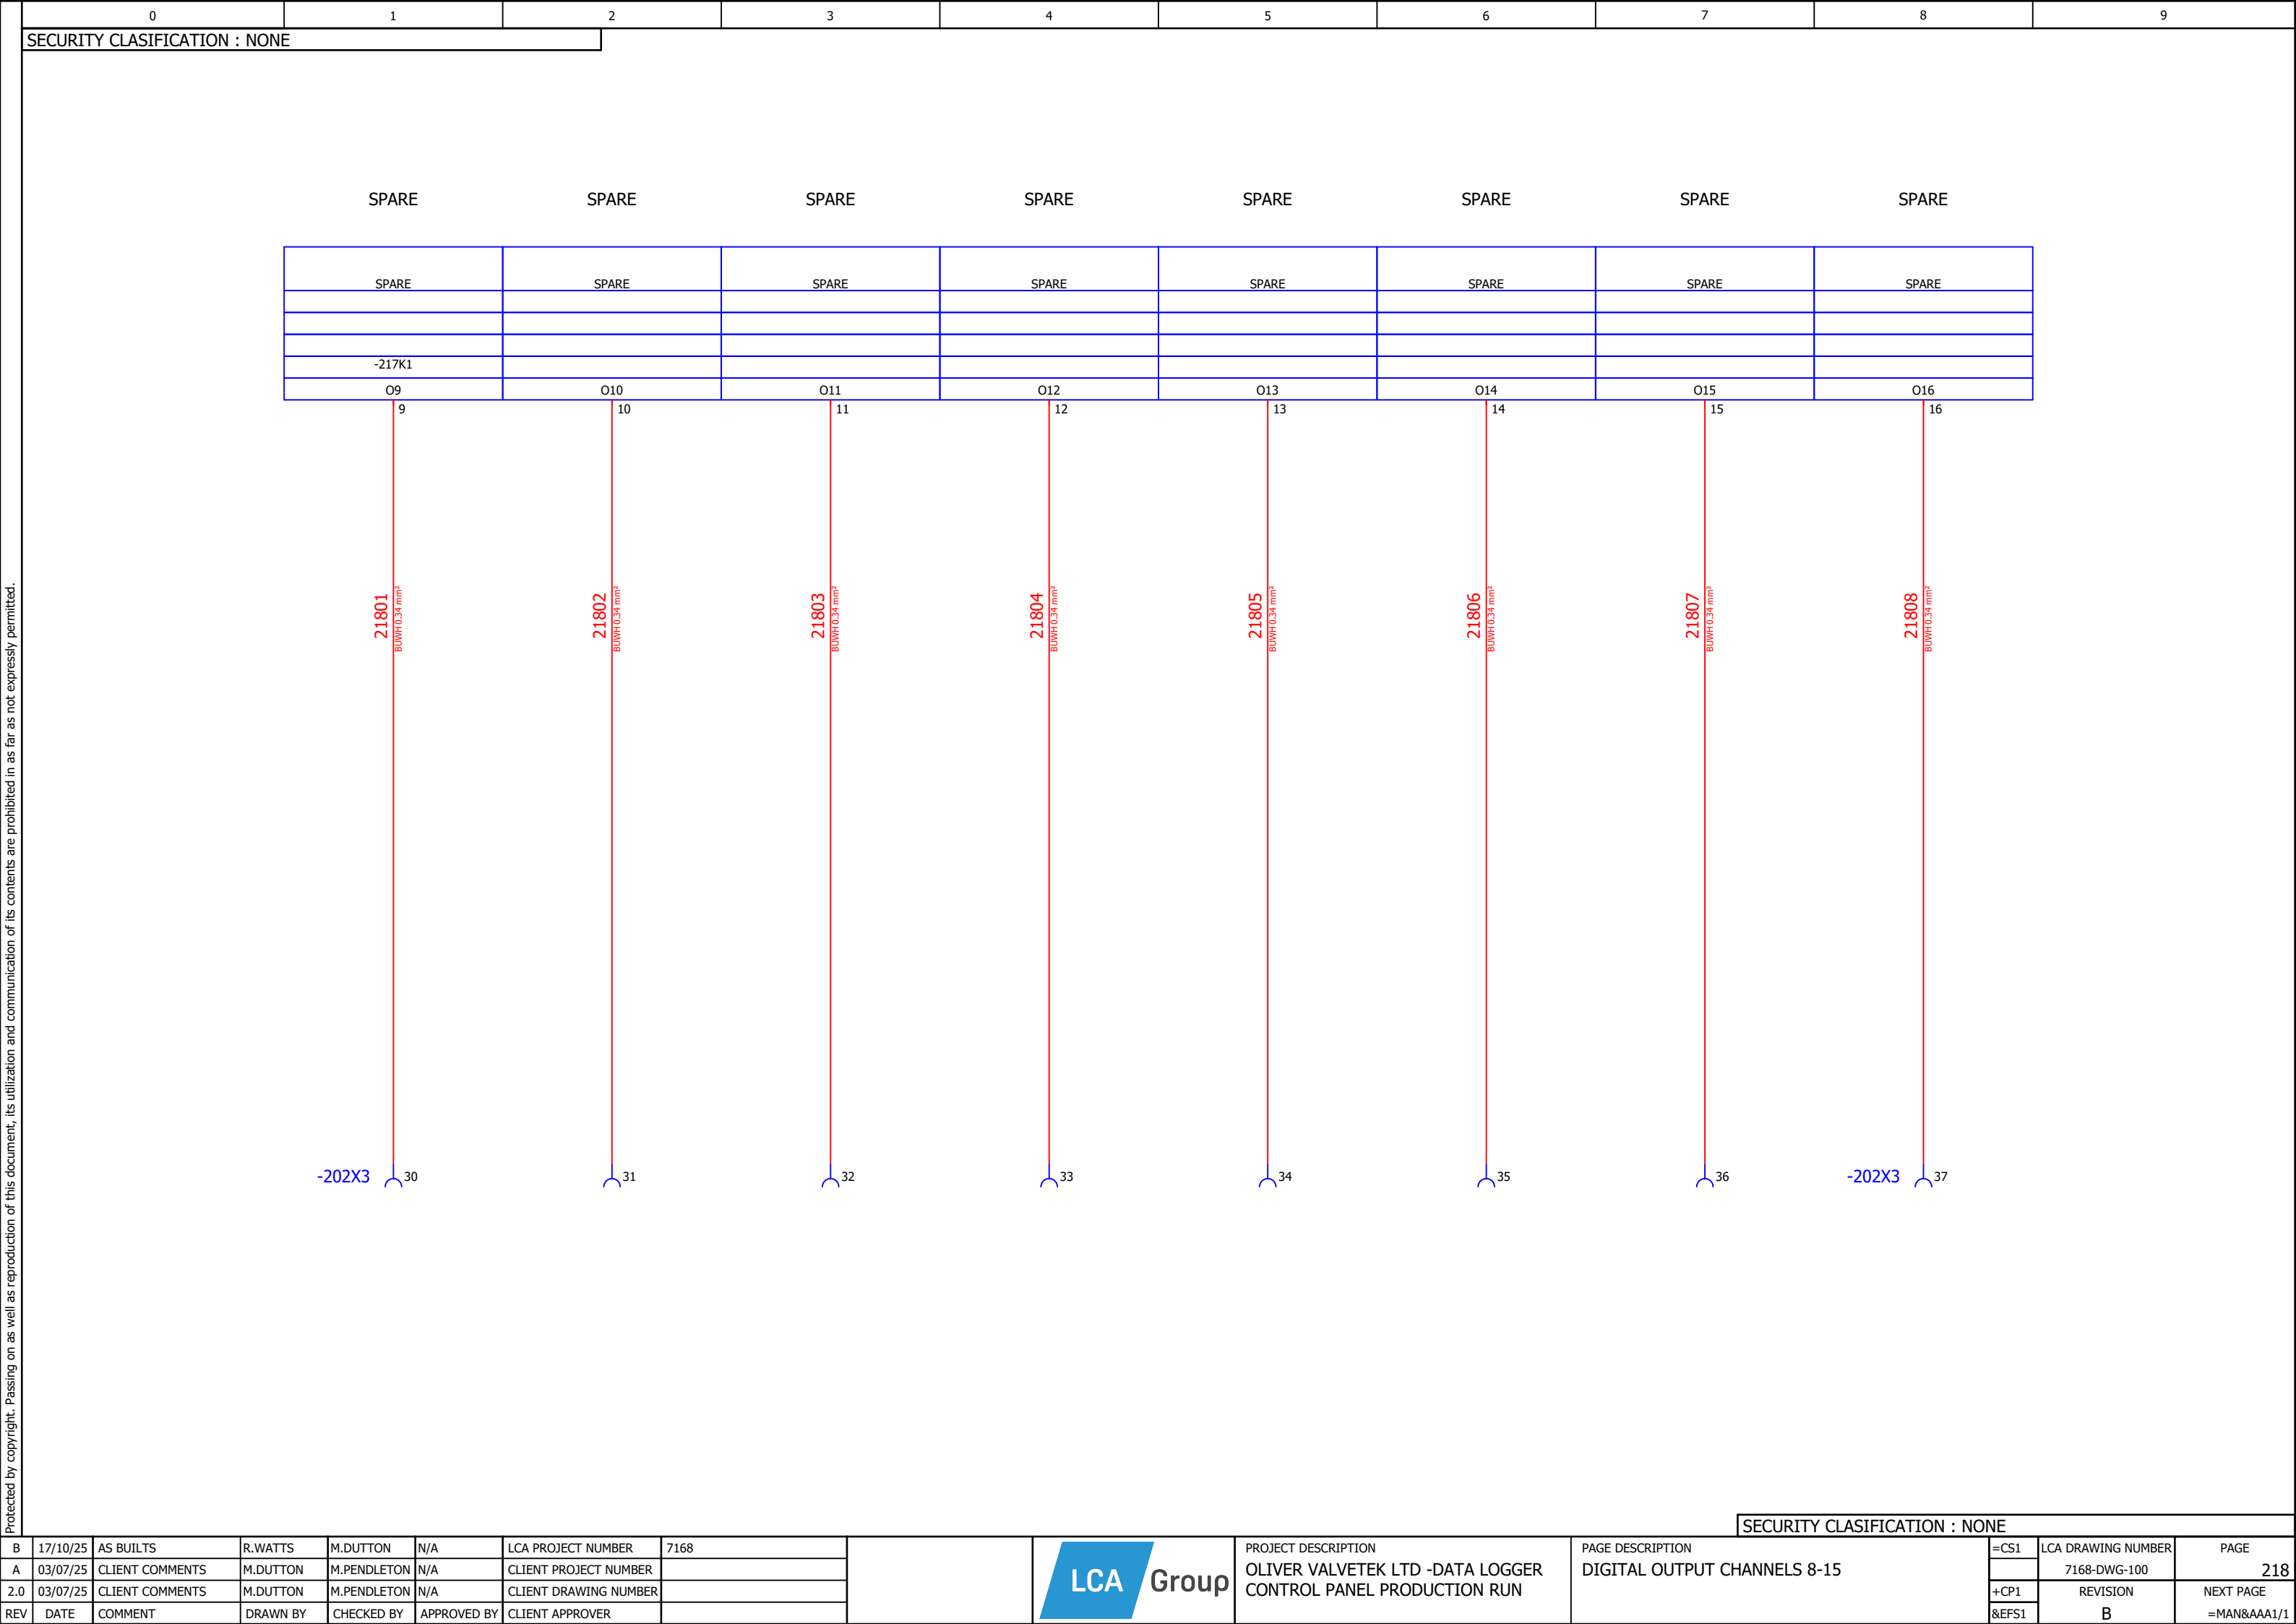

SECURITY CLASIFICATION : NONE

|     |          |                 |          |             |             |                       |      |  |                      |                                                                                         |                                                  |       |                    |             |
|-----|----------|-----------------|----------|-------------|-------------|-----------------------|------|--|----------------------|-----------------------------------------------------------------------------------------|--------------------------------------------------|-------|--------------------|-------------|
| B   | 17/10/25 | AS BUILTS       | R.WATTS  | M.DUTTON    | N/A         | LCA PROJECT NUMBER    | 7168 |  | <div>LCA Group</div> | PROJECT DESCRIPTION<br>OLIVER VALVETEK LTD -DATA LOGGER<br>CONTROL PANEL PRODUCTION RUN | PAGE DESCRIPTION<br>DIGITAL OUTPUT CHANNELS 8-15 | =CS1  | LCA DRAWING NUMBER | PAGE        |
| A   | 03/07/25 | CLIENT COMMENTS | M.DUTTON | M.PENDLETON | N/A         | CLIENT PROJECT NUMBER |      |  |                      |                                                                                         |                                                  |       | 7168-DWG-100       | 218         |
| 2.0 | 03/07/25 | CLIENT COMMENTS | M.DUTTON | M.PENDLETON | N/A         | CLIENT DRAWING NUMBER |      |  |                      |                                                                                         |                                                  | +CP1  | REVISION           | NEXT PAGE   |
| REV | DATE     | COMMENT         | DRAWN BY | CHECKED BY  | APPROVED BY | CLIENT APPROVER       |      |  |                      |                                                                                         |                                                  | &EFS1 | B                  | =MAN&AAA1/1 |

